

WAYNE
H 160
8-8-73

MISSISSIPPI
BOARD OF WATER COMMISSIONERS
416 North State Street
Jackson, Mississippi 39201

CODED
SEP 12 1973

WATER WELL DRILLERS LOG

SS. BD. 06

WATER CONTROL

Aug 8 1973
date well completed

Porter Drilling & Log
firm name

W
county well located

LANDOWNER: Clayton Blair

description of formations encountered

from

to

244 Wagnersboro Miss
(mailing address)

red clay	0	3
red clay with shales	3	30
chalk	30	48
red shales	48	55
blue chalk	55	67
fine blue sand	67	74
bituminous chalk		

WELL LOCATION:

sec. 14 T 9 N R 7 E
4 miles N of Wagnersboro
(distance) (direction) (nearest town)

WELL PURPOSE: home
(home, irrigation, municipal, industrial)

WELL COMPLETION DATA:

- (1) diameter (inches) 2"
- (2) total depth (feet) 74'
- (3) static water level (feet) 42' below top of ground.
- (4) casing steel 6.3' (material) (depth)
2' (size) if telescope see back.
- (5) screen 6' 68' (length) (depth to top)
1/4" 90 ga brass jacket (size) (material)
- (6) pump 1 (HP) 8 (yield gpm)
elec. (type power)
- (7) electric log no (yes or no)
- (organization running log)


6' 1 1/2" 90 ga brass screen with 5' 1 1/2" log fixed in well jacket
58' CODED

(8) how well bottom plugged
flush ground

DRILLERS REMARKS:

If well telescopes please sketch and show depths.

GROUND LEVEL

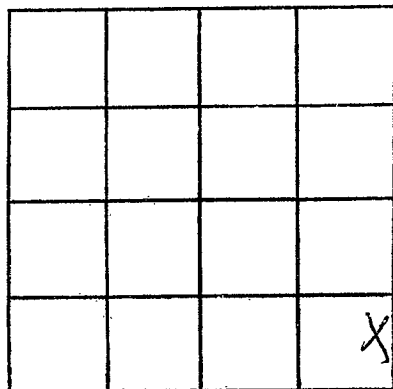

SECTION 14

Please indicate well location X.

ADDITIONAL INFORMATION

If more than one screen,
show locations of each on sketch.