

**WAYNE**  
**H 162**  
**2-11-74**

MISSISSIPPI  
 BOARD OF WATER COMMISSIONERS  
 416 North State Street  
 Jackson, Mississippi 39201

WATER WELL DRILLERS LOG

CODED

2-11-1974 date well completed  
 Rty McDonald & Hill Inc firm name  
 Wayne county well located

LANDOWNER: Ethel & Howard Whitfield  
 Rty, Waynesboro, Miss (mailing address)

description of formations encountered	from	to
clay	0	20
sand & gravel	20	36
clay + sand	36	98
course sand	98	119

WELL LOCATION: sec. 36 T. 10 N. R. 7 W.  
 7 1/2 miles south of Hiram (distance) (direction) of (nearest town)

WELL PURPOSE: home (home, irrigation, municipal, industrial)

- WELL COMPLETION DATA:
- (1) diameter (inches) 2
  - (2) total depth (feet) 119
  - (3) static water level (feet) 98 below top of ground.
  - (4) casing 2" PVC 114' (material), (depth)  
 no (size) if telescope see back.
  - (5) screen 5' #10 1 1/4" (length), (depth to top)  
 2" Plastic (size), (material)
  - (6) pump (HP) (yield gpm)  
 (type power)
  - (7) electric log no (yes or no)  
 (organization running log)
  - (8) how well bottom plugged back pressure valve


CODED

DRILLERS REMARKS: none

REC-15 1074  
 FEB 15 1974  
 MISSISSIPPI BOARD OF WATER COMMISSIONERS

If well telescopes please sketch and show depths.

GROUND LEVEL

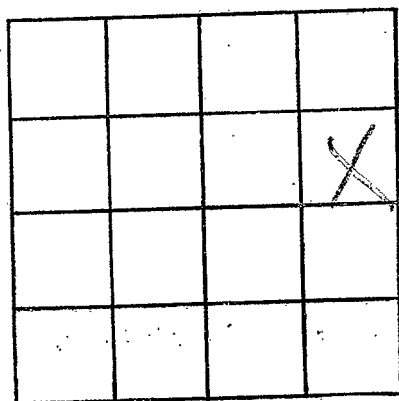

SECTION 36

Please indicate well location X.

ADDITIONAL INFORMATION

If more than one screen,  
show locations of each on sketch.