

**WAYNE**  
**H 163**  
**2-5-74**

MISSISSIPPI  
 BOARD OF WATER COMMISSIONERS  
 416 North State Street  
 Jackson, Mississippi 39201

**CODED**

**WATER WELL DRILLERS LOG**

FEB 5, 1974 19 McILWAIN WATER WELL SERVICE WAYNE  
 date well completed RT, Box 37 county well located  
WAYNESBORO, MISS. 39367


LANDOWNER:	description of fomations encountered	from	to
<u>Louis Ramey</u>	<u>Red Clay</u>	<u>0</u>	<u>10</u>
<u>RT 4 WAYNESBORO, Miss.</u> (mailing address)	<u>Red sand and Clay</u>	<u>10</u>	<u>18</u>
WELL LOCATION: sec. <u>11</u> T. <u>9</u> N R. <u>7</u> W <u>5</u> miles <u>N</u> of <u>W'BORO</u> (distance) (direction) (nearest town)	<u>Coarse Sand, some gravel</u>	<u>18</u>	<u>22</u>
WELL PURPOSE: (home, irrigation, municipal, industrial)	<u>Clay</u>	<u>22</u>	<u>27</u>
WELL COMPLETION DATA:	<u>Sand and gravel</u>	<u>27</u>	<u>29</u>
(1) diameter (inches) <u>2"</u>	<u>brown clay</u>	<u>29</u>	<u>32</u>
(2) total depth (feet) <u>38'</u>	<u>med sand</u>	<u>32</u>	<u>38</u>
(3) static water level (feet) <u>26'</u> below top of ground.			
(4) casing <u>PVC</u> , <u>33'</u> (material) (depth) <u>2"</u> (size) if telescope see back.			
(5) screen <u>5'</u> , <u>33'</u> (length) (depth to top) <u>2"</u> , <u>PVC .008</u> (size) (material)			
(6) pump <u>1</u> , <u>8</u> (HP) (yield gpm) <u>220 AC</u> (type power)			
(7) electric log <u>NO</u> (yes or no)			
(organization running log)			
(8) how well bottom plugged			
DRILLERS REMARKS:			

**CODED**

FEB 10 1974  
 MISSISSIPPI BOARD OF WATER COMMISSIONERS

If well telescopes please sketch and show depths.

GROUND LEVEL

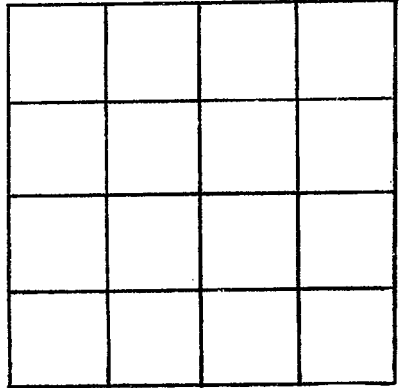

SECTION \_\_\_\_\_

Please indicate well location X.

ADDITIONAL INFORMATION

If more than one screen, show locations of each on sketch.