

WAYNE
H 164
3-19-74

MISSISSIPPI
 BOARD OF WATER COMMISSIONERS
 416 North State Street
 Jackson, Mississippi 39201
CODED

WATER WELL DRILLERS LOG

219 1974 CARR well service WAYNE
 date well completed firm name county well located

LANDOWNER: DEAN CLARK
Waynesboro Miss
 (mailing address)

description of formations encountered	from	to
TOP SOIL	0	1
Red sandy clay	1	3
COARSE Red SAND	3	12
COARSE yellowish sand	17	30
COARSE white sand	30	33
PER GRAVEL	33	67

WELL LOCATION:
 sec. 21 T 9N R 7E
2 miles ENE of Waynesboro
 (distance) (direction) (nearest town)

WELL PURPOSE: CHICKEN HOUSE
 (home, irrigation, municipal, industrial)

WELL COMPLETION DATA:

(1) diameter (inches) 4" X 4"

(2) total depth (feet) _____

(3) static water level (feet) 4' 6" ^{below} _{above} top of ground.

(4) casing PVC, 56'
 (material) (depth)
 (size) If telescope see back.

(5) screen 6, 56
 (length) (depth to top)
2', PVC slot
 (size) (material)

(6) pump 1/2, 9
 (HP) (yield gpm)
Elect
 (type power)

(7) electric log No
 (yes or no)

(organization running log) _____

(8) how well bottom plugged 2" B.W.V.


CODED

DRILLERS REMARKS: still in
PER GRAVEL when quit

APR - 4 1974
 MISS. Bd. OF WATER COMMISSIONERS

If well telescopes please sketch and show depths.

GROUND LEVEL

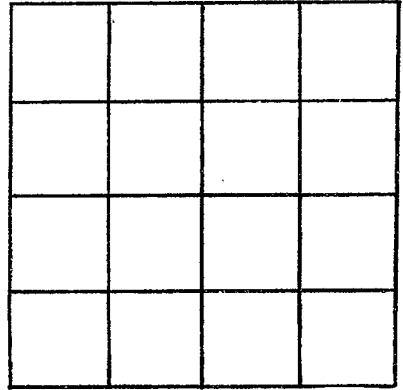

SECTION _____

Please indicate well location X.

ADDITIONAL INFORMATION

If more than one screen,
show locations of each on sketch.