

WAYNE
H 165
4-1-74

MISSISSIPPI
BOARD OF WATER COMMISSIONERS
416 North State Street
Jackson, Mississippi 39201

WATER WELL DRILLERS LOG

CODED

April 1 1974 Boyer Drilling Wayne
date well completed firm name county well located

LANDOWNER: Walter Graham

description of formations encountered

from

to

211 Skubuta Miss
(mailing address)

1 change	0	19
2 clay chalk	19	68
3 sand	68	69
4 gravel	69	70
5 sand stratus	70	75

WELL LOCATION:

sec 6 T 9 (N) R 7 (E)
8 miles (distance) NW (direction) of Waynesboro (nearest town)

WELL PURPOSE: home
(home, irrigation, municipal, industrial)

WELL COMPLETION DATA:

- (1) diameter (inches) 2"
- (2) total depth (feet) 75'
- (3) static water level (feet) 44' (below/above top of ground)
- (4) casing steel (material) 68' (depth)
- (5) screen none (length) none (depth to top)
- (6) pump 1 (HP) 12 (yield gpm)
- (7) electric log no (yes or no)

CODED


(8) how well bottom plugged open

DRILLERS REMARKS:

APR 25 1974

If well telescopes please sketch and show depths.

GROUND LEVEL

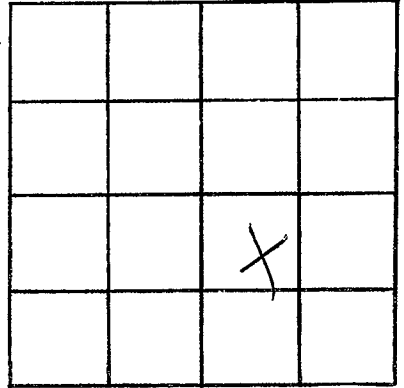

SECTION 6

Please indicate well location X.

ADDITIONAL INFORMATION

If more than one screen,
show locations of each on sketch.