

BOARD OF WATER COMMISSIONERS

416 North State Street

Jackson, Mississippi 39201

CODED

WAYNE

H 166

6-21-74

WATER WELL DRILLERS LOG

June 21 1974 date well completed

Porter Drilling Co. firm name

Wayne county well located

LANDOWNER: Walter Williams

Williams

description of formations encountered

from

to

12 N. Main Street (mailing address)

| | | |
|------------------------|-----|-----|
| cracked clay & sand | 0 | 15 |
| fine sand | 15 | 57 |
| rock | 57 | 58 |
| sand | 58 | 69 |
| blue chalk | 69 | 97 |
| fine sand & some chalk | 97 | 112 |
| blue chalk | 112 | 127 |
| rock strata | 127 | 147 |
| blue chalk | 147 | 154 |
| sand | 154 | 157 |
| blue chalk | 157 | 180 |
| shale | 180 | 210 |

WELL LOCATION:


sec 33 T 9 N R 7 E 3 miles NW of Bogalusa (nearest town)

WELL PURPOSE: (home, irrigation, municipal, industrial)

WELL COMPLETION DATA:

- (1) diameter (inches) 2"
- (2) total depth (feet) 210'
- (3) static water level (feet) 134' below top of ground
- (4) casing steel (material), 193' (depth)
- (5) screen 2" (size) if telescope see back.
- (6) screen iron (material), 193' (depth to top)
- (7) pump 3 1/2 (HP), elec. (type power)
- (8) electric log no (yes or no)

angle set at 157'

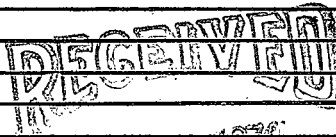

DRILLERS REMARKS:

sketch and show depths

GROUND LEVEL

| | | | |
|---|--|--|--|
| X | | | |
| | | | |
| | | | |
| | | | |

SECTION 33

Please indicate well location X.

ADDITIONAL INFORMATION

If more than one screen,
show locations of each on sketch.