

WAYNE  
H 167  
5-18-74

MISSISSIPPI  
BOARD OF WATER COMMISSIONERS  
416 North State Street  
Jackson, Mississippi 39201

CODED

WATER WELL DRILLERS LOG

May 18 1974 Porter Drilling & Log Wayne  
date well completed firm name county well located

LANDOWNER: Jim Waller

At 1 Waynesboro  
(mailing address)

WELL LOCATION:  
sec. 8 T 90 N R 7 E  
6 miles NW of Waynesboro  
(distance) (direction) (nearest town)

WELL PURPOSE: home  
(home, irrigation, municipal, industrial)

WELL COMPLETION DATA:

- (1) diameter (inches) 2'
- (2) total depth (feet) 105'
- (3) static water level (feet) 72 <sup>below</sup> <sub>above</sub> top of ground.
- (4) casing steel, 92'  
(material) (depth)  
2' if telescope see back.  
(size)
- (5) screen none used  
(length) (depth to top)  
(size) (material)
- (6) pump 1 9  
(HP) (yield gpm)  
elec  
(type power)
- (7) electric log no  
(yes or no)  
(organization running log)
- (8) how well bottom plugged open

description of formations encountered	from	to
<u>red clay</u>	<u>0</u>	<u>15</u>
<u>sand</u>	<u>15</u>	<u>25</u>
<u>red chalk</u>	<u>25</u>	<u>40</u>
<u>blue chalk</u>	<u>40</u>	<u>70</u>
<u>Waynesboro</u>	<u>70</u>	<u>105</u>
<u>2 1/2' 1" drop pipe</u>		

CODED


RECEIVED  
JUL 24 1974

DRILLERS REMARKS:

MISSISSIPPI BOARD OF WATER COMMISSIONERS

If well telescopes please sketch and show depths.

GROUND LEVEL

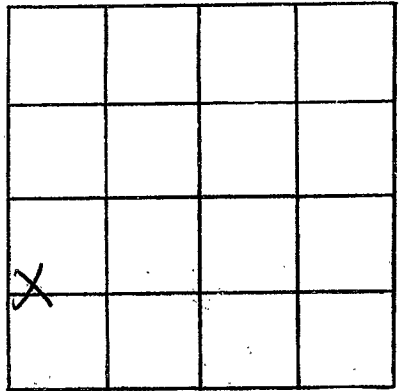

SECTION 8

Please indicate well location X.

ADDITIONAL INFORMATION

If more than one screen,  
show locations of each on sketch.