

WAYNE
H 168
9-26-74

MISSISSIPPI
BOARD OF WATER COMMISSIONERS
416 North State Street
Jackson, Mississippi 39201

WATER WELL DRILLERS LOG

CODED

April 26 1974 date well completed
D. L. Dillingham firm name
Wayne county well located

LANDOWNER: Spencer - Hudson

description of formations encountered

from to

Waynesboro, Miss.
(mailing address)

red clay	0	8
red silty clay	8	13
blue chalk	13	26
red silty clay	26	46
blue chalk	46	49
Waynesboro sand	49	61
blue chalk	61	81
Waynesboro rock	81	113

WELL LOCATION:

sec. 36 T 9 N R 7 E
2 miles N of Waynesboro
(distance) (direction) (nearest town)

WELL PURPOSE: none
(home, irrigation, municipal, industrial)

WELL COMPLETION DATA:

- (1) diameter (inches) 2"
- (2) total depth (feet) 113
- (3) static water level (feet) 61 (below/above top of ground)
- (4) casing steel 81' (material) (depth)
- 2" (size) if telescope see back.
- (5) screen none used (length) (depth to top)
- (size) (material)
- (6) pump 1/2 (HP) 10 (yield gpm)
- elec. (type power)
- (7) electric log no (yes or no)

79' 1/2" deep pipe

CODED

RECEIVED


APR 24 1974

DRILLERS REMARKS:

MISS. BD. OF WATER

If well telescopes please sketch and show depths.

GROUND LEVEL

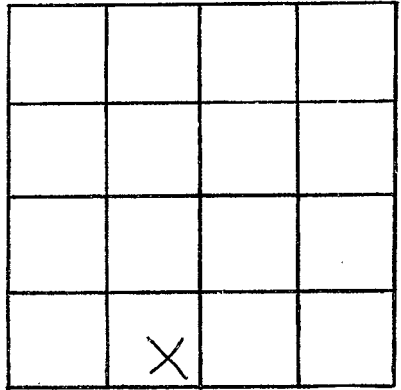

SECTION 36

Please indicate well location X.

ADDITIONAL INFORMATION

If more than one screen,
show locations of each on sketch.