

WAYNE
H 170
7-20-74

MISSISSIPPI
 BOARD OF WATER COMMISSIONERS
 416 North State Street
 Jackson, Mississippi 39201

CODED

WATER WELL DRILLERS LOG

July 20, 1974 date well completed McILWAIN WATER WELL SERVICE Wayne county well located
 RT. 2 BOX 37 WAYNESBORO, MISS. 39367

LANDOWNER:
BOBBY DEAN
Waynesboro, Miss.
 (mailing address)

description of formations encountered	from	to
<u>Red Clay</u>	<u>0</u>	<u>12</u>
<u>Red Sand</u>	<u>12</u>	<u>15</u>
<u>Coarse Sand + pea gravel some clay</u>	<u>15</u>	<u>32</u>
<u>Coarse Sand</u>	<u>32</u>	<u>40</u>
<u>Sand + gravel</u>	<u>40</u>	<u>54</u>

WELL LOCATION:
 sec. 7 T. 9 N. R. 7 E.
9 miles NW of W'BORO
 (distance) (direction) (nearest town)

WELL PURPOSE: HOME
 (home, irrigation, municipal, industrial)

- WELL COMPLETION DATA:**
- (1) diameter (inches) 2"
 - (2) total depth (feet) 54'
 - (3) static water level (feet) 41' below top of ground.
 - (4) casing PVC, 49' (material) (depth)
2" if telescope see back. (size)
 - (5) screen 5', 49' (length) (depth to top)
2", PVC .008 (size) (material)
 - (6) pump 1, 10 (HP) (yield gpm)
110 AC (type power)
 - (7) electric log NO (yes or no)
 (organization running log)
 - (8) how well bottom plugged _____

CODED


RECEIVED
AUG 13 1974

MISS. BD. OF WATER COMMISSIONERS

DRILLERS REMARKS:

If well telescopes please sketch and show depths.

GROUND LEVEL

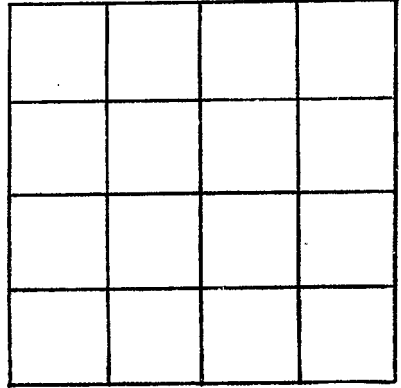

SECTION _____

Please indicate well location X.

ADDITIONAL INFORMATION

If more than one screen,
show locations of each on sketch.