

**MISSISSIPPI
BOARD OF WATER COMMISSIONERS**
416 North State Street
Jackson, Mississippi 39201

CODED

WATER WELL DRILLERS LOG

WAYNE
H 172
8-21-74

Aug 21 1974 Porter Drilling Wayne
date well completed firm name county well located

LANDOWNER: Leroy Langley

Rt 1 Waynesboro
(mailing address)

WELL LOCATION:
sec 31 T. 9 N. R. 7 E.
5 miles W of Waynesboro
(distance) (direction) (nearest town)

WELL PURPOSE: home
(home, irrigation, municipal, industrial)

WELL COMPLETION DATA:

- (1) diameter (inches) 2"
- (2) total depth (feet) 154'
- (3) static water level (feet) 114' (below top of ground)
- (4) casing steel, 150' (material) (depth)
2" (size) if telescope see back.
- (5) screen 4', 150' (length) (depth to top)
1 1/2" (size) (material) cast SS
- (6) pump 1 1/2, 5 (HP) (yield gpm)
elec. (type power)
- (7) electric log _____ (yes or no)

(organization running log)

(8) how well bottom plugged flush point


DRILLERS REMARKS: _____

description of formations encountered	from	to
red clay to sand	0	24
cherty bone sand	24	60
weather sand	60	120
sand w/ chalk	120	127
fine sand	127	132
lost circulation		
at 132'		
fine loose sand	132	154
stagnant water		
still in sand and		
getting from toward		
center		
4' 1/4" cast SS		
with 2' 1/4" log		
test in well packer		
126' 1/4" drop pipe		

RECEIVED
SEP 11 1974

If well telescopes please sketch and show depths.

GROUND LEVEL

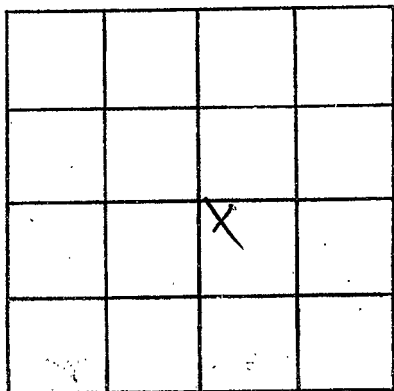

SECTION 31

Please indicate well location X.

ADDITIONAL INFORMATION

If more than one screen, show locations of each on sketch.