

WAYNE
H173
8-8-74

MISSISSIPPI
BOARD OF WATER COMMISSIONERS
416 North State Street
Jackson, Mississippi 39201

CODED

WATER WELL DRILLERS LOG

Aug 8 1974 Roy West Water Wells Wayne
date well completed firm name county well located

LANDOWNER: Frank West

Rt 1 Waynesboro

Box 774

(mailing address)

description of formations encountered

from

to

Clay

0

6

Sand

6

7.0

Clay

20

65

Lime Rock

65

80

WELL LOCATION:

sec. 18 T. 9 N. R. 7 E
S W
10 miles E of Waynesboro
(distance) (direction) (nearest town)

WELL PURPOSE: Home
(home, irrigation, municipal, industrial)

WELL COMPLETION DATA:

- (1) diameter (inches) 2 in
(2) total depth (feet) 80 ft
(3) static water level (feet) 40 below top of ground.
(4) casing galv 65 (material) (depth)

if telescope see back.
(size)

- (5) screen 0 0
(length) (depth to top)

0 0
(size) (material)

- (6) pump 1 7
(HP) (yield gpm)

REA
(type power)

- (7) electric log NO
(yes or no)

(organization running log)

- (8) how well bottom plugged Open End


DRILLERS REMARKS:

RECEIVED
OCT - 7 1974

MISSISSIPPI BOARD OF WATER COMMISSIONERS

If well telescopes please sketch and show depths.

GROUND LEVEL

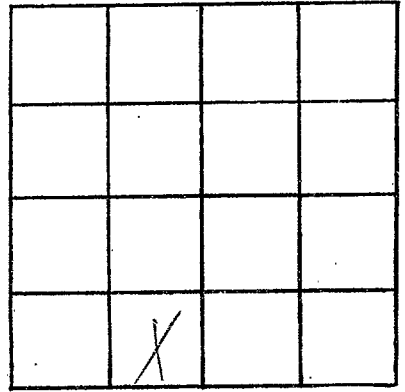

SECTION 18

Please indicate well location X.

ADDITIONAL INFORMATION

If more than one screen,
show locations of each on sketch.