

WAYNE
H 179
9/20/79

MISSISSIPPI
BOARD OF WATER COMMISSIONERS
416 North State Street
Jackson, Mississippi 39201

CODED

WATER WELL DRILLERS LOG
MILLWAIN WATER WELL SERVICE


Sept 20, 1979
date well completed

RT. 2 BOX 37

Wayne
county well located

WAYNESBORO, MISS. 39367


LANDOWNER:	description of formations encountered	from	to
Paul Clark			
Waynesboro, Miss. (mailing address)	Red sand	10	15
WELL LOCATION:	Sand and		
sec. 32 T 9 N R 7 W	Some clay	15	63
5 miles W of W'BORO (distance) (direction) (nearest town)	Gravel & coarse sand	63	85
WELL PURPOSE: HOME (home, irrigation, municipal, industrial)			
WELL COMPLETION DATA:			
(1) diameter (inches) 2"			
(2) total depth (feet) 85'			
(3) static water level (feet) 54' below top of ground			
(4) casing PVC 80' (material) (depth)			
2" if telescope see back. (size)			
(5) screen 5' 80' (length) (depth to top)			
2" PVC .008 (size) (material)			
(6) pump 3/4 7 (HP) (yield gpm)			
110 AC (type power)			
(7) electric log NO (yes or no)			
(organization running log)			
(8) how well bottom plugged			
DRILLERS REMARKS:			

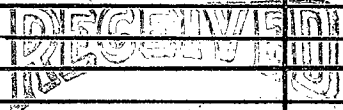

NOV 8 1979

If well telescopes please sketch and show depths.

GROUND LEVEL

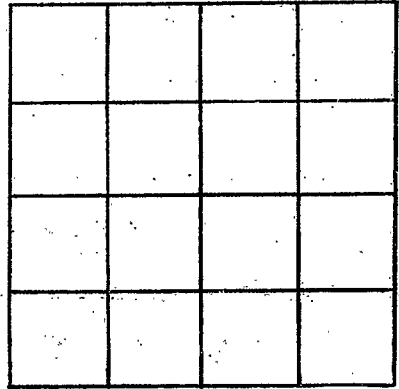

SECTION _____

Please indicate well location X.

ADDITIONAL INFORMATION

If more than one screen, show locations of each on sketch.