

WAYNE
H 175
1-22-75

MISSISSIPPI
BOARD OF WATER COMMISSIONERS
416 North State Street
Jackson, Mississippi 39201 **CODED**

WATER WELL DRILLERS LOG

JAN 22 - 75 19 **McILWAIN WATER WELL SERVICE** WAYNE
date well completed RT. firm name BOX 57 county well located
WAYNESBORO MISS 39367


LANDOWNER:	description of formations encountered	from	to
PLEASANT GROVE BAP. CHURCH	Red Clay	0	12
WAYNESBORO, Miss (mailing address)	Red Sand	12	20
WELL LOCATION:	Clay	20	32
sec. 12 T 9 N R 7 E 6 miles N of W'BORO (distance) (direction) (nearest town)	Sand & Clay streaks	32	39
WELL PURPOSE: CHURCH (home, irrigation, municipal, industrial)	Clay	39	55
WELL COMPLETION DATA:	Rock layers	55	60
(1) diameter (inches) 2"	clay	60	90
(2) total depth (feet) 134'			
(3) static water level (feet) 115' below top of ground	Fine Sand and Clay	90	120
(4) casing PVC (material) 129' (depth)	Med Sand	120	134
2" (size) if telescope see back.			
(5) screen 5' (length) 129' (depth to top)			
2" (size) PVC .008 (material)			
(6) pump 1 (HP) 4.5 (yield gpm)			
220 AC (type power)			
(7) electric log NO (yes or no)			
(organization running log)			
(8) how well bottom plugged			
DRILLERS REMARKS:			

DEC 10 1975
FEB 10 1975

MISS. RD. OF WATER COMMISSIONERS

If well telescopes please sketch and show depths.

GROUND LEVEL

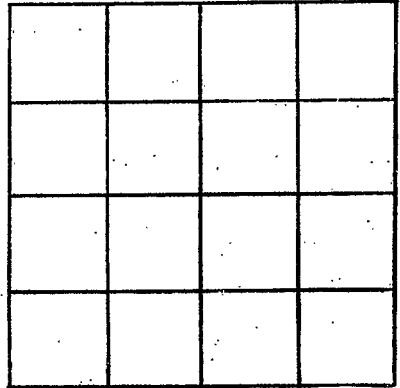

SECTION _____

Please indicate well location X.

ADDITIONAL INFORMATION

If more than one screen, show locations of each on sketch.