

WAYNE  
H 176  
1-23-75

MISSISSIPPI  
BOARD OF WATER COMMISSIONERS  
416 North State Street  
Jackson, Mississippi 39201

P. CLARK  
WATER WELL DRILLING  
ROUTE 2  
LAUREL, MISS. 39440

WATER WELL DRILLERS LOG

CODED  
Wayne

11-23-1975 date well completed  
C.P. Clark firm name  
Wayne county well located

LANDOWNER: George Waller  
Pt # 1  
Waynesboro Miss  
(mailing address)

description of formations encountered	from	to
Sandy Clay	0	15
Medium Sand	15	90
hard coarse sand	90	102


WELL LOCATION:  
sec. 20 T. 9N R. 7E  
S W  
4 1/2 miles NW of Waynesboro  
(distance) (direction) (nearest town)

WELL PURPOSE: Home  
(home, irrigation, municipal, industrial)

- WELL COMPLETION DATA:
- (1) diameter (inches) 2
  - (2) total depth (feet) 102
  - (3) static water level (feet) 92 below top of ground.
  - (4) casing Galv. Iron 97  
(material) (depth)
  - (size) if telescope see back.
  - (5) screen 5 97  
(length) (depth to top)
  - 1 1/4 Solid S.S.  
(size) (material)
  - (6) pump 1 1/2 6 2/3  
(HP) (yield gpm)
  - 2200 S.P.  
(type power)
  - (7) electric log No  
(yes or no)

(organization running log)  
(8) how well bottom plugged B W U

DRILLERS REMARKS: Set 9 ft  
(a) 95 ft

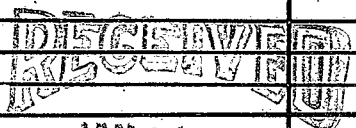

JAN 31 1975

If well telescopes please sketch and show depths.

GROUND LEVEL

X			

SECTION 20

Please indicate well location X.

ADDITIONAL INFORMATION

If more than one screen, show locations of each on sketch.