

BOARD OF WATER COMMISSIONERS

416 North State Street

Jackson, Mississippi 39201

WAYNE

H 177

1-9-75

WATER WELL DRILLERS LOG

CODED

Jan 9 1975 date well completed

Booth Drilling & Log firm name

Wayne county well located

LANDOWNER: Tom Haller

description of formations encountered

from to

RT 1, Waynesboro Miss (mailing address)

rest clay	0	18
sh. s. s.	18	55
chall.	55	104
fine sand & chall.	104	120
chall.	120	139
rock stratum	139	150
chall.	150	180
rock stratum	180	210

WELL LOCATION: sec 29 T 9 N R 7 E 13P 3 miles NW of Waynesboro (distance) (direction) (nearest town)


WELL PURPOSE: home (home, irrigation, municipal, industrial)

CODED

WELL COMPLETION DATA:

- (1) diameter (inches) 2"
- (2) total depth (feet) 210'
- (3) static water level (feet) 133' below top of ground.
- (4) casing steel 180' (material) (depth) 2' (size) if telescope see back.
- (5) screen none present (length) (depth to top) (size) (material)
- (6) pump 2 (HP) 5 (yield gpm) elec. (type power)
- (7) electric log no (yes or no)
- (organization running log)
- (8) how well bottom plugged open


DRILLERS REMARKS:

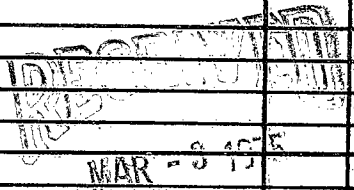

MISS. BD. OF WATER COMMISSIONERS

If well telescopes please sketch and show depths.

GROUND LEVEL

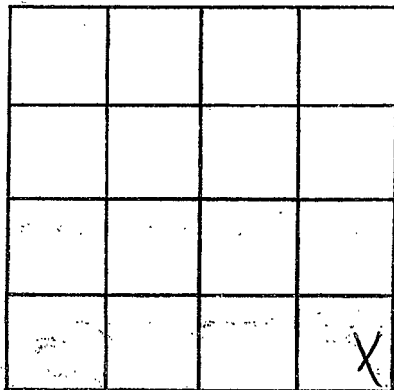

SECTION 29

Please indicate well location X.

ADDITIONAL INFORMATION

If more than one screen,
show locations of each on sketch.