

WAYNE

H178

2-25-75

BOARD OF WATER COMMISSIONERS

416 North State Street

Jackson, Mississippi 39201

WATER WELL DRILLERS LOG

CODED

Feb 25 1975
date well completed

Port Dalling
firm name

Wayne
county well located

LANDOWNER: Ward

description of formations encountered

from

to

Shelley
At h Hengersonboro
(mailing address)

well clay 0 11
blue clay 11 14
well strata 14 49
well 49 87
back 87 84
well strata 84 119

WELL LOCATION:

sec 36 T 9 N R 2 13P
1 miles N of Marysville
(distance) (direction) (nearest town)

WELL PURPOSE: none
(home, irrigation, municipal, industrial)

63' 1 1/4" drop pipe

WELL COMPLETION DATA:

(1) diameter (inches) 2"
(2) total depth (feet) 119
(3) static water level (feet) 55' below above top of ground.
(4) casing steel 87'
(material) (depth)

CODED

2' If telescope see back.
(size)
(5) screen none used
(length) (depth to top)

(size) (material)
(6) pump 1 3
(HP) (yield gpm)


elec.
(type power)

(7) electric log no
(yes or no)

(organization running log)

(8) how well bottom plugged open

DRILLERS REMARKS:

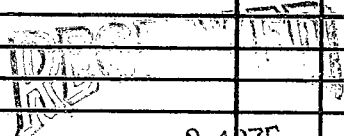

MAR - 3 1975

MISS. BD OF WATER COMMISSIONERS

If well screened, do profile
sketch and show depths.

GROUND LEVEL

		X	

SECTION 36

Please indicate well location X.

ADDITIONAL INFORMATION

If more than one screen,
show locations of each on sketch.