

WAYNE
H 180
3-26-75

MISSISSIPPI
 BOARD OF WATER COMMISSIONERS
 416 North State Street
 Jackson, Mississippi 39201

CODED

WATER WELL DRILLERS LOG

MARCH 26, 1975 ¹⁹ **McILWAIN WATER WELL SERVICE** **WAYNE**
 date well completed Rt. 4, Box 31 county well located
WAYNESBORO, MISS. 39367

LANDOWNER:
MR. JOHN WALLER
WAYNESBORO, Miss.
 (mailing address)

WELL LOCATION:
 sec. 7 T 9 N R. 7 E
7 miles NW of W'BORO
 (distance) (direction) (nearest town)

WELL PURPOSE: HOME
 (home, irrigation, municipal, industrial)

WELL COMPLETION DATA:

(1) diameter (inches) 2"

(2) total depth (feet) 120'

(3) static water level (feet) 73' below above top of ground.

(4) casing PVC, 101'
 (material) (depth)
2" if telescope see back.
 (size)

(5) screen NONE, —
 (length) (depth to top)
 (size) (material)

(6) pump 1 HP., 7
 (HP) (yield gpm)
220 AC
 (type power)

(7) electric log no
 (yes or no)

(organization running log)

(8) how well bottom plugged

| description of formations encountered | from | to |
|---------------------------------------|--------|--------|
| Red Clay | 0 | 12 |
| " Sand | 12 | 15 |
| White Clay | 15 | 28 |
| Sand Rock | 28 | 28 1/2 |
| Yellow Clay | 28 1/2 | 30 |
| Blue clay | 30 | 38 |
| Rock layers + Clay | 38 | 45 |
| blue clay | 45 | 95 |
| Honey comb Rock | 95 | 120 |

CODED


RECEIVED
APR 14 1975

APR 14 1975

DRILLERS REMARKS:

If well telescopes please sketch and show depths.

GROUND LEVEL

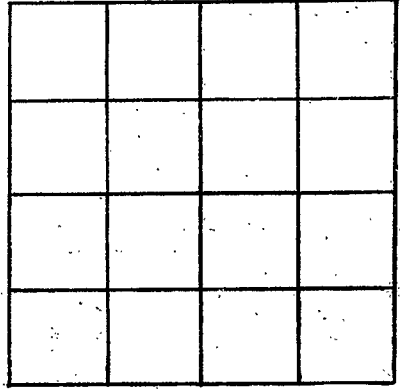

SECTION _____

Please indicate well location X.

ADDITIONAL INFORMATION

Lined area for additional information.

If more than one screen, show locations of each on sketch.