

Wayne
H 181
4-4-75

MISSISSIPPI
BOARD OF WATER COMMISSIONERS
416 North State Street
Jackson, Mississippi 39201

CODED

WATER WELL DRILLERS LOG

April 4 1975 Porter Drilling & Exp Wayne
date well completed firm name county well located

LANDOWNER: <u>Blair Gray</u>	description of formations encountered	from	to
<u>At 621 Wagnersboro Miss</u> (mailing address)	<u>red clay</u>	<u>0</u>	<u>20</u>
	<u>orange sand clay</u>	<u>20</u>	<u>39</u>
	<u>clay</u>	<u>39</u>	<u>45</u>
	<u>sand</u>	<u>45</u>	<u>50</u>
	<u>sand</u>	<u>50</u>	<u>57</u>
	<u>clay</u>	<u>57</u>	<u>60</u>
	<u>Clay to sand</u>	<u>60</u>	<u>75</u>
	<u>sand with fine</u>	<u>75</u>	<u>113</u>
	<u>strat on clay</u>		

WELL LOCATION:
sec. 1 T. 90 N. R. 7 E. W.
7 miles N of Wagnersboro
(distance) (direction) (nearest town)

WELL PURPOSE: Home
(home, irrigation, municipal, industrial)

- WELL COMPLETION DATA:
- (1) diameter (inches) 2"
 - (2) total depth (feet) 113'
 - (3) static water level (feet) 85' (below/above top of ground)
 - (4) casing P.V.C. (material) 108' (depth)
2' (size) If telescope see back.
 - (5) screen 5' (length) 108' (depth to top)
1 1/4" (size) 2 slot S.S. (material)
 - (6) pump 1 (HP) 4 (yield gpm)
elec (type power)
 - (7) electric log no (yes or no)

(organization running log)

(8) how well bottom plugged back wash valve


DRILLERS REMARKS:

102' 1" P.V.C. down pipe
5' 1 1/4" 2 slot S.S. screen
screwed on end of case.
with back wash valve
and 8' steel trap
above

DISCOVER/STI
MAY - 6 1975
MISS. Bd. OF WATER COMM

If well telescopes please sketch and show depths.

GROUND LEVEL

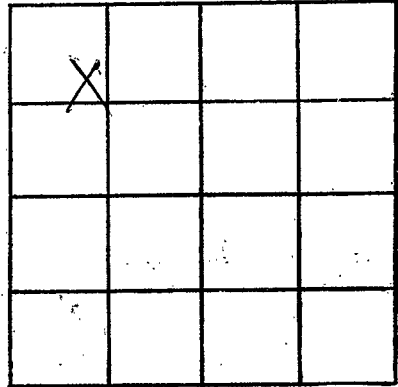

SECTION 1

Please indicate well location X.

ADDITIONAL INFORMATION

If more than one screen, show locations of each on sketch.