

Wayne
H 183
6-9-75

MISSISSIPPI
BOARD OF WATER COMMISSIONERS
416 North State Street
Jackson, Mississippi 39201

00210


WATER WELL DRILLERS LOG

June 9 1975 date well completed
25 Part Drilling & Log firm name
Wayne county well located

LANDOWNER: Clark	description of formations encountered	from	to
Cypress or Haynesboro (mailing address)	red clay	0	18
	blue clay	18	24
WELL LOCATION: 34 90 7 13P sec. T N R E S W 2 miles NW Haynesboro (distance) (direction) (nearest town)	rock strata	24	42
	blue clay	42	81
WELL PURPOSE: home (home, irrigation, municipal, industrial)	black silt	81	105
	white clay & some rock	105	140
WELL COMPLETION DATA: (1) diameter (inches) 2" (2) total depth (feet) 555 (3) static water level (feet) P below top of ground. above (4) casing steel (material) 512 (depth) 2' (size) If telescope see back. (5) screen none used (length) (depth to top) (6) pump none 15 flow (HP) (yield/gpm) brown water (material) (type power) (7) electric log no (yes or no) (organization running log) (8) how well bottom plugged	blue clay	140	140
	rock strata	140	352
DRILLERS REMARKS: 16 1975	brown sand	352	373
	rock strata	373	381
MISS. BD. OF WATER COMM	blue clay	381	400
	thin rock	400	460
	clay thin sand	460	490
	clay	490	501
	dark fine sand	501	510
	softer clay	510	518
	light sand	518	525
	clay	525	532
	dark fine sand	532	536
	thin rock	536	536
	shell & sand	536	540
	dark fine sand	540	547
	clay & sand	547	555
	shell large on mud at base. 3 wings 1 1/2" long 1/2" wide		
	52' local response on mud		
	on mud with hole at 460'		

If well telescopes please sketch and show depths.

GROUND LEVEL

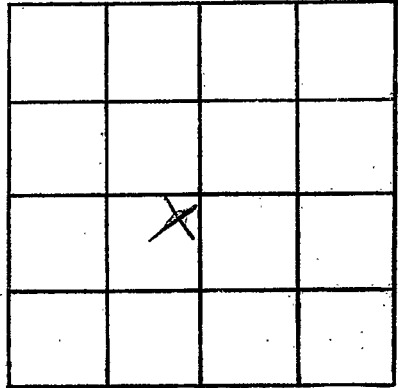

SECTION 324

Please indicate well location X.

ADDITIONAL INFORMATION

If more than one screen,
show locations of each on sketch.