

Wayne
H 184
6-2-75

MISSISSIPPI
BOARD OF WATER COMMISSIONERS
416 North State Street
Jackson, Mississippi 39201

CODED

WATER WELL DRILLERS LOG

June 2, 1975 19 McILWAIN WATER WELL SERVICE Wayne
date well completed RT. file name BOX 37 county well located
WAYNESBORO, MISS. 39367

LANDOWNER:
MR Edward Pitts
Waynesboro, Miss.
(mailing address)

description of formations encountered	from	to
Red Clay	0	8
Red Sand	8	35
Coarse Sand some gravel	35	45
sand + clay	45	64
Coarse dark sand + sand rock	64	72
Coarse white sand	72	83

WELL LOCATION:
sec. 32 T. 9 N R. 7 W 13P
5 miles NW of W'BORO
(distance) (direction) (nearest town)

WELL PURPOSE: HOME
(home, irrigation, municipal, industrial)


- WELL COMPLETION DATA:
- (1) diameter (inches) 2"
 - (2) total depth (feet) 83'
 - (3) static water level (feet) 58' below top of ground.
 - (4) casing PVC 78' (material) (depth)
2" (size) if telescope see back.
 - (5) screen 5' 78' (length) (depth to top)
2" PVC .008 Slot (size) (material)
 - (6) pump 1 11 (HP) (yield gpm)
220 AC (type power)
 - (7) electric log NO (yes or no)
 - (organization running log)
 - (8) how well bottom plugged

DRILLERS REMARKS:

DRILLERS
JUN 2 1975
MISS. Bd. of WATER CONTROL

If well telescopes please
sketch and show depths.

GROUND LEVEL

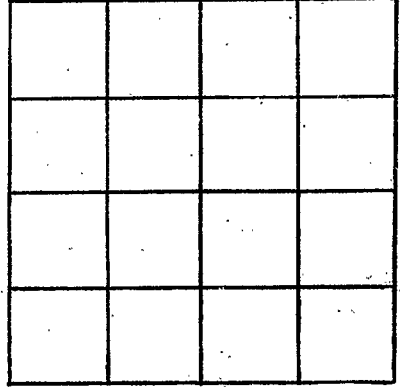

SECTION _____

Please indicate well location X.

ADDITIONAL INFORMATION

If more than one screen,
show locations of each on sketch.