

Waverly
 H 185
 7-16-75

MISSISSIPPI
 BOARD OF WATER COMMISSIONERS
 416 North State Street
 Jackson, Mississippi 39201

CODED

WATER WELL DRILLERS LOG

July 16, 1975 Porter Drilling Co Waverly
 date well completed firm name county well located

LANDOWNER: J L Arnold Jr
At 1 Waverly
 (mailing address)

description of formations encountered	from	to
rest clay	0	20
rest sand	20	93
chalky sand	93	95

WELL LOCATION:
 sec. 18 T. 9 N. R. 7 E. 13P
5 miles NW of Waverly
 (distance) (direction) (nearest town)

5' 1 1/4" hole SS
 screwed on end of case

WELL PURPOSE: Home
 (home, irrigation, municipal, industrial)

with backwash valve

- WELL COMPLETION DATA:
- (1) diameter (inches) 2'
 - (2) total depth (feet) 94
 - (3) static water level (feet) 75 (below top of ground)
 - (4) casing PVC, 98'
(material) (depth)
2' if telescope see back.
(size)
 - (5) screen 5', 98'
(length) (depth to top)
1 1/4" hole SS
(size) (material)
 - (6) pump 1 1/2, 9
(HP) (yield gpm)
elec
(type power)
 - (7) electric log no
(yes or no)

on end & shall trays at base
 82' 1" P.V.C. casing pipe

(organization running log)

RECORDED
 AUG 26 1975


(8) how well bottom plugged
back wash valve

DRILLERS REMARKS:

MISSISSIPPI BOARD OF WATER COMMISSIONERS

If well telescopes please sketch and show depths.

GROUND LEVEL

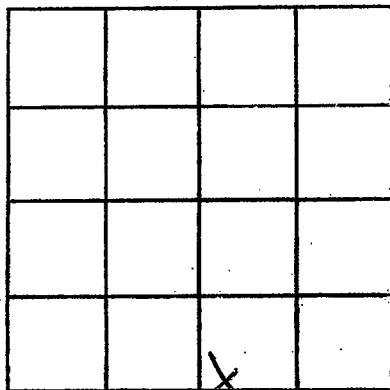

SECTION 18

Please indicate well location X.

ADDITIONAL INFORMATION

If more than one screen,
show locations of each on sketch.