

CODED

Wayne
H 186
9-8-75

MISSISSIPPI
BOARD OF WATER COMMISSIONERS
416 North State Street
Jackson, Mississippi 39201

WATER WELL DRILLERS LOG
McILWAIN WATER WELL SERVICE

SEPT 8, 1975 19 date well completed RT. 2 BOX 37 WAYNESBORO, MISS. 39367 Wayne county well located

LANDOWNER:
William Ray Donald
RT 6 WAYNESBORO, Miss.
(mailing address)

description of formations encountered	from	to
Red Sandy Clay	0	8
" Sand	8	12

WELL LOCATION:
sec. 25 T 9 N R 7 W 13P
3 miles N of W. BORO
(distance) (direction) (nearest town)

Sand + clay streaks	12	23
Clay	23	30
Sand + Clay	30	40

WELL PURPOSE: Home
(home, irrigation, municipal, industrial)

yellow Clay	40	43
-------------	----	----

WELL COMPLETION DATA:

- (1) diameter (inches) 2"
- (2) total depth (feet) 101'
- (3) static water level (feet) 90' below top of ground
- (4) casing PVC 2" (material) 96' (depth) if telescope see back.
- (5) screen 5' 2" (length) 96' (depth to top) PVC .008 (material)
- (6) pump 1 (HP) 5 (yield gpm) 110 AC (type power)
- (7) electric log NO (yes or no)
- (8) how well bottom plugged


Blue Clay	43	45
Thin rocks + clay	45	75
Brown Clay	75	85
Sand	85	88
Clay	88	91
Sand	91	101

DRILLERS REMARKS:

RECEIVED
SEP 15 1975
MISS. Bd. OF WATER COMMISSIONERS

If well telescopes please sketch and show depths.

GROUND LEVEL

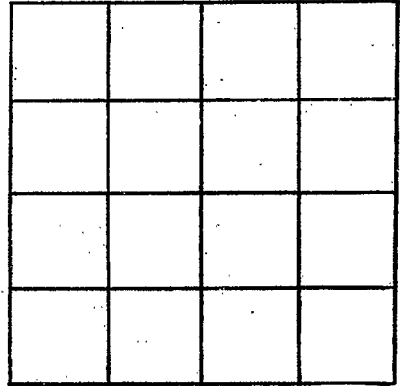

SECTION _____

Please indicate well location X.

ADDITIONAL INFORMATION

If more than one screen, show locations of each on sketch.