

WAYNE
H 187
11/1/78

MISSISSIPPI
BOARD OF WATER COMMISSIONERS
416 North State Street
Jackson, Mississippi 39201

CODED

WATER WELL DRILLERS LOG

1978 11/1 date well completed 79 Park Rolling Hills firm name Wayne county well located

LANDOWNER: Kentick
Phyllis J. Miss
Waynesboro Miss.
(mailing address)

WELL LOCATION:
sec 7 T 9N R 7
6 miles N of Waynesboro
(distance) (direction) (nearest town)

WELL PURPOSE: camp
(home, irrigation, municipal, industrial)

WELL COMPLETION DATA:
(1) diameter (inches) 2"
(2) total depth (feet) 353'
(3) static water level (feet) + below
top of ground.
(4) casing steel 338'
(material) (depth)
2"
(size) If telescope see back.
(5) screen 15' 338'
(length) (depth to top)
2" balck S.S.
(size) (material)
(6) pump 2 16
(HP) (yield gpm)
15 gal flow
(type power)
(7) electric log no
(yes or no)
(organization running log)

(8) how well bottom plugged
2" back wash valve

description of formations encountered	from	to
shale	0	24
blue clay	24	112
rock strata	110	125
blue clay CODED	115	125
rock strata	125	216
clay	216	217
grey sand	219	222
rock	222	223
clay	223	229
rock strata	229	237
clay	237	285
grey fine sand	285	294
rock	294	296
grey coarse sand	294	330
rock	330	339
sand	339	353
stagnant on clay		

Miss. Board of Water Comm.


FEB 8 1979

RECEIVED

DRILLERS REMARKS:
28' 11" steel casing
2' cut off casing

If well telescopes please sketch and show depths.

GROUND LEVEL

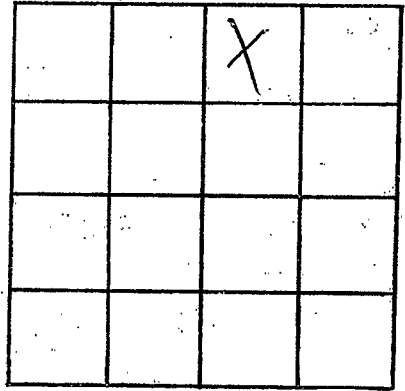

SECTION 9

Please indicate well location X.

ADDITIONAL INFORMATION

If more than one screen,
show locations of each on sketch.