

WAYNE

H-189
4-29-80

MISSISSIPPI
BOARD OF WATER COMMISSIONERS
416 North State Street
Jackson, Mississippi 39201

CODED

WATER WELL DRILLERS LOG

4-29-80 Griner Drilling Wayne Co.

date well completed

firm name

county well located

LANDOWNER:
Kaiser Oil U.S.A.
410 17 Street
Denver, Colorado 80202
(mailing address)

description of formations
encountered

from to

WELL LOCATION: 697' N 702 E
Hudson mineral trust 6-T-9 R-20 SW 1/4
#1 West Yellow Crk. Field
(distance) (direction) (nearest town)

sand 0 42
Chalk-rock 42 147

rock-shell 147 168
Chalk-shell 168 231

WELL PURPOSE: oil field supply
(home, irrigation, municipal, industrial)

Chalk-rock 231 294
shell-chalk 294 462

WELL COMPLETION DATA:

- (1) diameter (inches) 3"
- (2) total depth (feet) 882'
- (3) static water level (feet) 175' below top of ground.
- (4) casing steel, 861' (material) (depth)
3" If telescope see back. (size)
- (5) screen 42', 819' (length) (depth to top)
3", perforated (size) (material)
- (6) pump - 75 (HP) (yield gpm)
AC (type power)
- (7) electric log (yes or no)
- (organization running log)

sand 462 525
Chalk-shell 525 704
streaked 704 756
sand 756 861

DEPT. OF NATURAL RESOURCES
BUREAU OF LAND & WATER RESOURCES

MAY 20 1980


RECEIVED

DRILLERS REMARKS:

orange peel

If well telescopes please sketch and show depths.

GROUND LEVEL

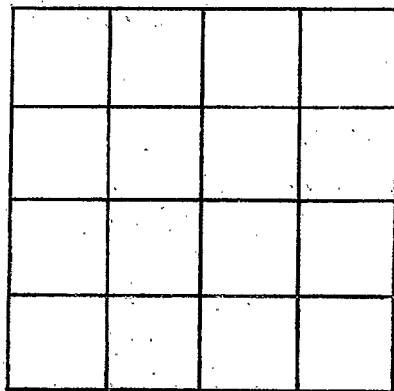

SECTION _____

Please indicate well location X.

ADDITIONAL INFORMATION

Lined area for additional information.

If more than one screen, show locations of each on sketch.