

MISSISSIPPI DEPARTMENT OF NATURAL RESOURCES

Bureau of Land and Water Resources

Southport Mall

P.O. Box 10631

Jackson, Mississippi 39209

CODED

WATER WELL DRILLERS LOG

WAYNE
H 195
9-23-81

Sept 23 1981 date well completed
Porter Drilling Co firm name
Wayne county well located

LANDOWNER: Deland Clark
Waynesboro, Miss.

(mailing address)

WELL LOCATION:
sec 27 T 9 (N) R 7 E (W)
2 miles N.W. of Waynesboro
(distance) (direction) (nearest town)

WELL PURPOSE:
(home, irrigation, municipal, industrial)

WELL COMPLETION DATA:

- (1) diameter (inches) 2"
- (2) total depth (feet) 460
- (3) static water level (feet) 15 ^{below} _{above} top of ground.
- (4) casing steel 445'
(material) (depth)
2' If telescope see back.
(size)
- (5) screen none used
(length) (depth to top)
(size) (material)
- (6) pump none 25 flow
(HP) (yield gpm)
none
(type power)
- (7) electric log no
(yes or no)
(organization running log)
- (8) how well bottom plugged open

description of formations encountered	from	to
Clay	0	6
sand	6	14
rock strata	14	17
Clay	17	50
sand & clay	50	57
sand	57	60
sand & clay	60	64
Clay	64	277
rock of sand strata	277	312
Clay	312	329
thin rock		329
Clay	329	368
thin rock		368
Clay some sand	368	387
Clay	387	426
sand	426	432
Clay	432	444
sand & rock	444	446
sand lignite shell	446	457
Clay	457	460

CODED

MISSISSIPPI DEPARTMENT OF NATURAL RESOURCES
BUREAU OF LAND & WATER RESOURCES


NOV 21 1981

RECEIVED

DRILLERS REMARKS:
42' 4" total depth
Clay to bed off cherty

If well telescopes please
sketch and show depths.

GROUND LEVEL

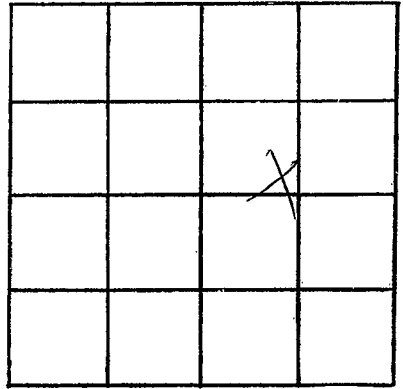

SECTION 27

Please indicate well location X.

ADDITIONAL INFORMATION

If more than one screen,
show locations of each on sketch.