

YNE
 A 196
 21778

MISSISSIPPI
 BOARD OF WATER COMMISSIONERS
 416 North State Street
 Jackson, Mississippi 39201

WATER WELL DRILLERS LOG

Feb. 7 1978 Porter Drilling & Supply Wayne
 date well completed firm name county well located

LANDOWNER: Glenn Graham

At 1. Shubert
 (mailing address)

WELL LOCATION:
 sec. 3 T. 9 N. R. 7 E. W. 1
 7 miles NW Napaola of (nearest town)

WELL PURPOSE: Home
 (home, irrigation, municipal, industrial)

WELL COMPLETION DATA:

- (1) diameter (inches) 2
- (2) total depth (feet) 158
- (3) static water level (feet) 118 (below top of ground)
- (4) casing Steel 152 (material) (depth)
 2 (size) if telescope see back.
- (5) screen none used (length) (depth to top)
- (6) pump Wood 3 1/2 (HP) (yield gpm)
 0 kw (type power)
- (7) electric log no (yes or no)
- (organization running log)
- (8) how well bottom plugged

DRILLERS REMARKS:

description of formations encountered	from	to
rest clay	0	30
sand & clay	30	60
sand	60	89
clay	89	90
loam and	90	98
clay	98	99
blue clay	99	152
Wicksburg	152	158
Best circulation at 152'		
Cylinder set at 147'		
salt water in sand at 98'		
Wicksburg also has some salt water intrusion		


RECEIVED

APR 11 1978

MISS. BD. OF WATER COMM.

If well telescopes please sketch and show depths.

GROUND LEVEL

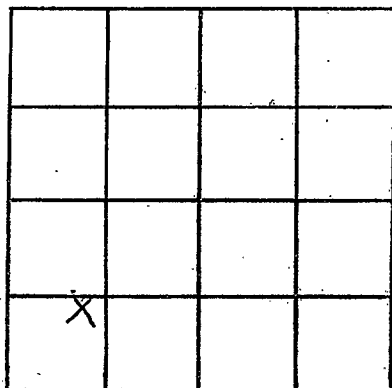

SECTION 5

Please indicate well location X.

ADDITIONAL INFORMATION

If more than one screen,
show locations of each on sketch.