

MISSISSIPPI DEPARTMENT OF NATURAL RESOURCES

Bureau of Land and Water Resources

Southport Mall

P.O. Box 10631

CODED

Jackson, Mississippi 39209

WATER WELL DRILLERS LOG

WAYNE
 H H 197
 3/9/83

March 9 1983 Porter Drilling, Inc Wayne
 date well completed firm name county well located

LANDOWNER: Noland Clark
Waynesboro, Miss.
 (mailing address)

WELL LOCATION:
 sec. 24 T. 9 (N) R. 7 E (W)
3 miles NW of Waynesboro
 (distance) (direction) (nearest town)

WELL PURPOSE: farm
 (home, irrigation, municipal, industrial)

WELL COMPLETION DATA:
 (1) diameter (inches) 2"
 (2) total depth (feet) 480'
 (3) static water level (feet) 15 below/above top of ground.
 (4) casing: steel, 463' (material) (depth)
2' if telescope see back. (size)
 (5) screen 16, 463 (length) (depth to top)
2", both S.S. (size) (material)
 (6) pump none, 20 (HP) (yield gpm)
 (type power)
 (7) electric log no (yes or no)
 (organization running log)

description of formations encountered	from	to
sand & gravel	0	9
clay	9	15
soft shales	15	25
clay	25	40
red shales	40	50
clay	50	300
red siltstone	300	320
Coar. sand	320	330
red shales	330	335
clay	335	395
thin red. s. s.		395
clay	395	410
month's bench	410	418
silt. clay	418	419
clay some sand	419	447
sand some clay	447	465
red clay sand	465	479
clay	479	480

CODED

DEPT. OF NATURAL RESOURCES
 BUREAU OF LAND & WATER RESOURCES

MAY 2 - 1983


RECEIVED

(8) how well bottom plugged
2' 2" tail pipe plugged in clay

DRILLERS REMARKS:
15' 6" P.V.C casing
40' 4" steel casing
Discontinuation at 16'

If well telescopes please sketch and show depths.

GROUND LEVEL

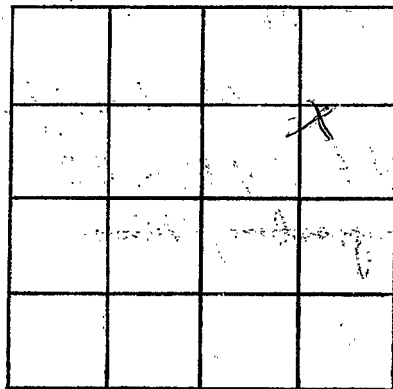

SECTION 34

Please indicate well location X.

ADDITIONAL INFORMATION

If more than one screen,
show locations of each on sketch.