

MISSISSIPPI DEPARTMENT OF NATURAL RESOURCES  
Bureau of Land and Water Resources

Southport Mall  
P.O. Box 10631

Jackson, Mississippi 39209

WATER WELL DRILLERS LOG

CODED

#198  
Wayne  
9-11-83

Griner Drilling  
Service, Inc.

Wayne

9-11-83  
date well completed

Griner Drilling  
Service, Inc.  
firm name

Wayne  
county well located


LANDOWNER:	description of formations encountered	from	to
Tesoro Petroleum, Inc 1726 1/2 10th Street Laurel, Ms. 39440 (mailing address)	clay, rock streaked	0	231 449
WELL LOCATION: 1500'S + 500'W sec. 14 T 9N R 7 E NE/4COR No. 1011 J. M. Lamer N. Wayneboro (distance) (direction) (nearest town)	sand clay	449	466 483
WELL PURPOSE: oil field supply (home, irrigation, municipal, industrial)			
WELL COMPLETION DATA:	1500'S + 500'W of NE/4COR Sec 14-9N-7E		
(1) diameter (inches) 3"	LADD PETRO. CORP.		
(2) total depth (feet) 504'			
(3) static water level (feet) 35' below top of ground.			
(4) casing steel 462' (material) (depth) 3" (size) if telescope see back.			
(5) screen 42' 420' (length) (depth to top) 3" perforated (size) (material)			
(6) pump - 85-90 (HP) (yield gpm) AC (type power)			
(7) electric log (yes or no) (organization running log)			
(8) how well bottom plugged orange peel			
DRILLERS REMARKS:			

REPT. OF NATURAL RESOURCES  
BUREAU OF LAND & WATER RESOURCES

OCT 3 1983  
RECEIVED

If well-telescopes please sketch and show depths.

GROUND LEVEL

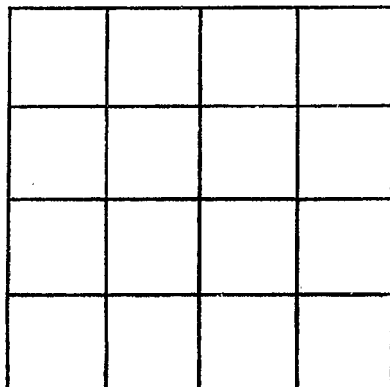

SECTION \_\_\_\_\_

Please indicate well location X.

ADDITIONAL INFORMATION

If more than one screen, show locations of each on sketch.