

MISSISSIPPI DEPARTMENT OF NATURAL RESOURCES

Bureau of Land and Water Resources

Southport Mall

P.O. Box 10631

Jackson, Mississippi 39209

WATER WELL DRILLERS LOG

CODED

WAYNE
H 199

Griner Drilling Service, Inc.

Wayne

10-5-84 date well completed

Griner Drilling Service, Inc. firm name

Wayne county well located

LANDOWNER:
Chesley Pruet Drilling
P.O. Box 324
Laurel, Ms.
(mailing address)

description of formations encountered	from	to
sand, clay, rocks	0	189
clay	189	252
clay, rocks	252	399
clay	399	462
sand, shell, clay	462	546
sand, shell, clay	546	882

WELL LOCATION: 1971N + 7031E
sec. 6 T. 90N R. 7 E of SW cor
No. 1 Hudson's Ms. Mineral Trust
Yellow Creek
(distance) (direction) (nearest town)

WELL PURPOSE: oilfield supply
(home, irrigation, municipal, industrial)

- WELL COMPLETION DATA:
- (1) diameter (inches) 3"
 - (2) total depth (feet) 882'
 - (3) static water level (feet) 100' below above top of ground.
 - (4) casing steel 504'
(material) (depth)
3" if telescope see back.
(size)
 - (5) screen Open ended
(length) (depth to top)
(size) (material)
 - (6) pump 70
(HP) (yield gpm)
AC
(type power)
 - (7) electric log (yes) (no)
(organization running log)
 - (8) how well bottom plugged orange peel

DRILLERS REMARKS:


DEPT. OF NATURAL RESOURCES
BUREAU OF LAND & WATER RESOURCES

OCT 22 1984 1304

RECEIVED

If well telescopes please
sketch and show depths.

GROUND LEVEL

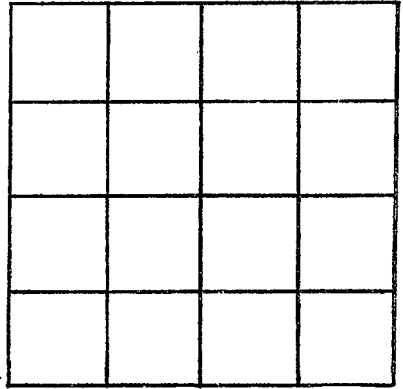

SECTION _____

Please indicate well location X.

ADDITIONAL INFORMATION

If more than one screen,
show locations of each on sketch.