

MISSISSIPPI DEPARTMENT OF NATURAL RESOURCES

Bureau of Land and Water Resources

Southport Mall

P.O. Box 10631

Jackson, Mississippi 39209

WATER WELL DRILLERS LOG

H200
Wayne

March 27 1985 date well completed
Dexter Drilling & Log firm name
Wayne county well located

LANDOWNER: John Lee
At 1. Waynesboro Ms.
(mailing address)


description of formations encountered	from	to
sand	0	20
clay	20	21
soft rock	21	32
Wicksburg rock	32	44
white clay some rock	44	60
29' 1 1/2" galv. logs		

WELL LOCATION:
sec 27 T 9 N R 7 E
3 miles N of Waynesboro
(distance) (direction) (nearest town)

WELL PURPOSE: chicken
(home, irrigation, municipal, industrial)

- WELL COMPLETION DATA:
- (1) diameter (inches) 2"
 - (2) total depth (feet) 60'
 - (3) static water level (feet) 1.3 below above top of ground.
 - (4) casing steel 31' (material) (depth)
2" (size) if telescope see back.
 - (5) screen none used (length) (depth to top)
 - (6) pump 1 12 (HP) (yield gpm)
elec (type power)
 - (7) electric log no (yes or no)
 - (organization running log)
 - (8) how well bottom plugged open

DRILLERS REMARKS:

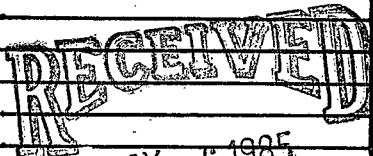


MAY - 6 1985

Department of Natural Resources
Bureau of Land & Water Resources

If well telescopes please sketch and show depths.

GROUND LEVEL

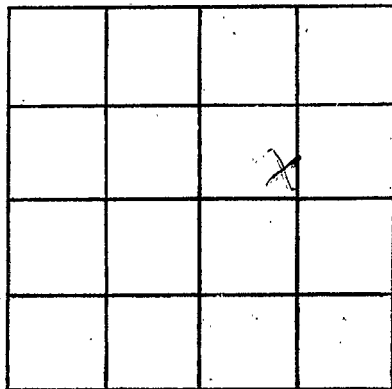

SECTION 27

Please indicate well location X.

ADDITIONAL INFORMATION

If more than one screen,
show locations of each on sketch.