




If well telescopes please sketch and show depths.

GROUND LEVEL

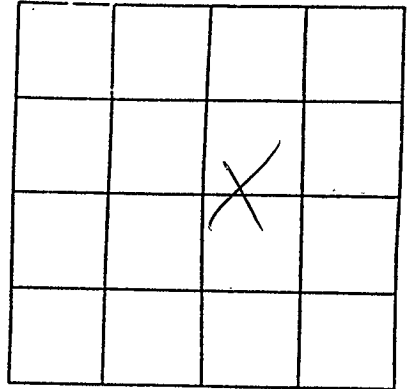

SECTION \_\_\_\_\_

Please indicate well location X.

|                           |               |                      |     |
|---------------------------|---------------|----------------------|-----|
| Pump Capacity (GPM)<br>55 | No. of Stages | Setting Depth<br>160 | FT. |
|---------------------------|---------------|----------------------|-----|

PUMP TEST

Well yielded 70 GPM with  
a drawdown of 10 ft.  
after 1 hours of pumping

LOG DATA

TYPE OF LOG RUN (Circle One): No Log Run,  
Electric, Gamma Ray, Density, Sonic, Neutron,  
Other (Describe) \_\_\_\_\_

Name of Organization Running Log

GEOLOGIC DATA (Office Use Only)

|               |               |                |              |
|---------------|---------------|----------------|--------------|
| Surface Elev. | Geologic Unit | Unit Thickness | Depth to Top |
| Subs. SWL     | Date          | Analysis       | Aquifer Test |

Driller's Remarks

If more than one screen,  
show location of each on sketch.