

WAYNE
 H 2001
 11-18-75

MISSISSIPPI
 BOARD OF WATER COMMISSIONERS
 416 North State Street
 Jackson, Mississippi 39201

WATER WELL DRILLERS LOG

Nov. 18 1975 *Porter Drilling Co* Wayne
 date well completed firm name county well located

LANDOWNER: *Wayne Co*
Lime Plant
Waynesboro Miss.
 (mailing address)

WELL LOCATION:
 sec. 23 T 9 N R 7 E
 S W
 4 miles N of *Waynesboro*
 (distance) (direction) (nearest town)

WELL PURPOSE: *industrial*
 (home, irrigation, municipal, industrial)

WELL COMPLETION DATA:

(1) diameter (inches) 4"

(2) total depth (feet) 446'

(3) static water level (feet) below
 top of ground. above

(4) casing steel 337' 4 1/2"
 (material) (depth) (size) if telescope see back.

(5) screen 115'
 (length) (depth to top)
2 1/2" beloit S.S.
 (size) (material)

(6) pump 25
 (HP) (yield, gpm)
flour
 (type power)

(7) electric log no
 (yes or no)

(organization running log)

(8) how well bottom plugged back wash valve


description of formations encountered	from	to
clay	0	12
sand	12	14
Clay & sand	14	23
rocks	23	24
clay & sand	24	32
shaly clay	32	94
rocks	94	95
blue clay	95	155
rocks strata	155	185
blue clay	185	245
rocks strata	245	262
coarse sand	262	266
clay	266	272
rock strata	272	280
clay	280	337
shaly rock		337
clay some sand	337	362
sand	362	367
chalk & sand	367	392
fine sand	392	404
chalk shell sand	404	410
hard fine sand	410	426
chalk & sand	426	429
fine clean sand	429	444
clay & sand	444	446

RECEIVED
 FEB 18 1976

DRILLERS REMARKS:
 42' 6" surface casing

If well telescopes please sketch and show depths.

GROUND LEVEL

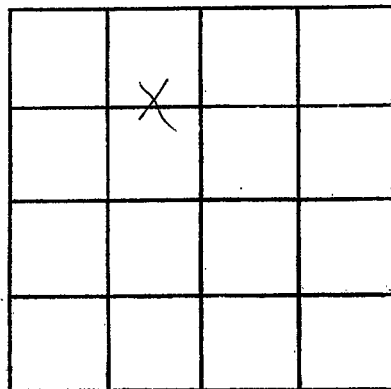

SECTION 23

Please indicate well location X.

ADDITIONAL INFORMATION

If more than one screen,
show locations of each on sketch.