

WAYNE

H 2002

1-15-76

MISSISSIPPI BOARD OF WATER COMMISSIONERS  
416 North State Street  
Jackson, Mississippi 39201

WATER WELL DRILLERS LOG

Jan 15  
date well completed

13P 76 Porter-Williams & Son  
firm name

Warren  
county well located

LANDOWNER: John McManey

description of formations encountered

from

to

B.O.P. 12 Magnolia Ave  
(mailing address)

sand & clay 0 3  
blue to red silt  
loam to red clay sand 3 15  
sand some clay 15 28  
2 7/8 gal on rock 28 29

WELL LOCATION:

sec 27 T 9 N R 7 E  
S W  
3 miles NW of Magnolia  
(distance) (direction) (nearest town)

WELL PURPOSE: Home  
(home, irrigation, municipal, industrial)

WELL COMPLETION DATA:


- (1) diameter (inches) 2"
- (2) total depth (feet) 23'
- (3) static water level (feet) 14' below top of ground
- (4) casing PVC 23' (material) (depth)  
2' if telescope see back. (size)
- (5) screen 5' 23' (length) (depth to top)  
1/4 inch 5.5 (size) (material)
- (6) pump 3/4 9 (HP) (yield gpm)  
elec. (type power)
- (7) electric log no (yes or no)

20' 1" PVC casing  
pipe  
5' 1/4" 6 slot 5.5  
Development on end of casing  
well back wash water on  
end of shell logs above

(organization running log)

(8) how well bottom plugged  
back wash water

DRILLERS REMARKS:

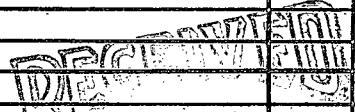


FEB 18 1976

MISSISSIPPI DEPARTMENT OF WATER CONSERVATION

If well telescopes please sketch and show depths.

GROUND LEVEL

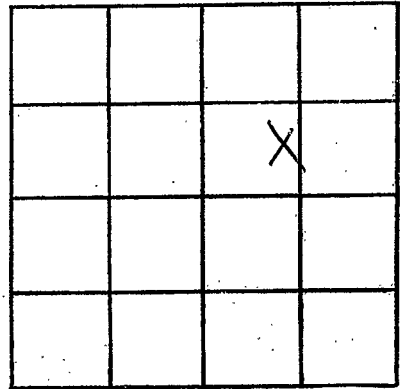

SECTION 27

Please indicate well location X.

ADDITIONAL INFORMATION

If more than one screen,  
show locations of each on sketch.