

WAYNE  
H 2003  
2-3-76

MISSISSIPPI  
BOARD OF WATER COMMISSIONERS  
416 North State Street  
Jackson, Mississippi 39201

WATER WELL DRILLERS LOG

Feb 3 1976 date well completed  
Dart Drilling firm name  
Wayne county well located


LANDOWNER: Gloria Graham  
211 Phubita Mine  
(mailing address)

WELL LOCATION:  
sec 6 T 9 (N) R 7 E (W)  
6 miles NW of Winneshob  
(distance) (direction) (nearest town)

WELL PURPOSE: None  
(home, irrigation, municipal, industrial)

- WELL COMPLETION DATA:
- (1) diameter (inches) 2'
  - (2) total depth (feet) 125'
  - (3) static water level (feet) 97' (below/above top of ground)
  - (4) casing steel 129'  
(material) (depth)  
2' If telescope see back.  
(size)
  - (5) screen none used  
(length) (depth to top)  
(size) (material)
  - (6) pump 2 8 1/2  
(HP) (yield gpm)  
elec  
(type power)
  - (7) electric log no  
(yes or no)
  - (organization running log)
  - (8) how well bottom plugged open


description of formations encountered	from	to
red clay & sand	0	2.5
white clay	2.5	4.5
hard red H. clay	4.5	5.7
shale	5.7	7.3
blue clay	7.3	12.9
hard blue gravel	12.9	16.5
126' 1/2' blue gravel	11	11
salt water - 73'		
water in back hole		
there was salt water		
contamination but not		
no bad as sand		

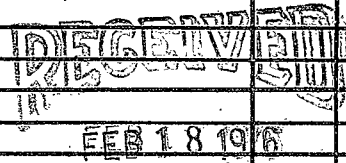

DRILLERS REMARKS:  
82' 4" cas to cut off salt water

If well telescopes please sketch and show depths.

GROUND LEVEL

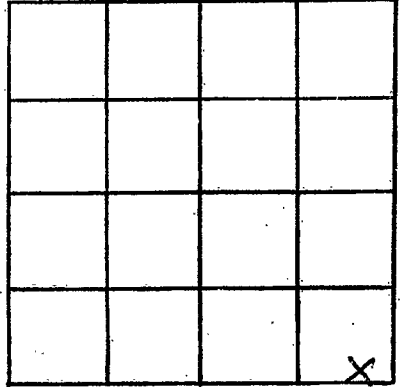

SECTION 6

Please indicate well location X.

ADDITIONAL INFORMATION

If more than one screen,  
show locations of each on sketch.