

Wayne
H 2006
3/4/76

MISSISSIPPI
BOARD OF WATER COMMISSIONERS
416 North State Street
Jackson, Mississippi 39201

WATER WELL DRILLERS LOG


McILWAIN WATER WELL SERVICE WAYNE

MARCH 4, 1976
date well completed

RT firm name BOX 57
WAYNESBORO, MISS. 39367

county well located

LANDOWNER:	description of formations encountered	from	to
(mailing address)			
ANTIOCH ASSEMBLY OF GOD CHURCH	Red Clay	0	5
WAYNESBORO, Miss.	Pink Clay	5	10
WELL LOCATION: sec. 29 T. 9 N R. 7 E 7 miles NW of W'BORO (distance) (direction) (nearest town)	Sand + Gravel	10	84
WELL PURPOSE: CHURCH (home, irrigation, municipal, industrial)	Yellow Clay	84	88
WELL COMPLETION DATA: (1) diameter (inches) 2" (2) total depth (feet) 173' (3) static water level (feet) 92' below top of ground. (4) casing PVC 140' (material) (depth) 2" (size) If telescope see back. (5) screen NONE (length) (depth to top) (size) (material) (6) pump 1 5 (HP) (yield gpm) 220 AC (type power) (7) electric log NO (yes or no) (organization running log) (8) how well bottom plugged	Blue Clay	88	92
	Lime Rock & Clay	92	115
	Blue Clay	115	140
	Honeycomb Rock	140	173
DRILLERS REMARKS:			

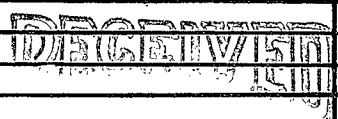

APR 20 1976

JMM

If well telescopes please sketch and show depths.

GROUND LEVEL

SECTION _____

Please indicate well location X.

ADDITIONAL INFORMATION

If more than one screen, show locations of each on sketch.