

Wayne
 H 2005
 3/18/76

MISSISSIPPI
 BOARD OF WATER COMMISSIONERS
 416 North State Street
 Jackson, Mississippi 39201

WATER WELL DRILLERS LOG

March 18, 1976
 date well completed

McILWAIN WATER WELL SERVICE

Wayne

RT. 2 BOX 37
 WAYNESBORO, MISS. 39367

county well located

LANDOWNER:
 Alton Cason
 WAYNESBORO, Miss.
 (mailing address)

description of formations encountered	from to	
Red Clay	0	5
Sand & Clay	5	12
Clay	12	19
Sand	19	31

WELL LOCATION:
 sec. 14 T 9 N R 7 W
 5 miles N of WAYNESBORO
 (distance) (direction) (nearest town)


WELL PURPOSE: Home
 (home, irrigation, municipal, industrial)

- WELL COMPLETION DATA:
- (1) diameter (inches) 2"
 - (2) total depth (feet) 31
 - (3) static water level (feet) 15' below top of ground.
 - (4) casing PVC 27' (material) (depth)
 2" (size) if telescope see back.
 - (5) screen 4' 27' (length) (depth to top)
 2" PVC .008 (size) (material)
 - (6) pump 3/4 10 (HP) (yield gpm)
 220 AC (type power)
 - (7) electric log No (yes or no)

(organization running log)

(8) how well bottom plugged


DRILLERS REMARKS:

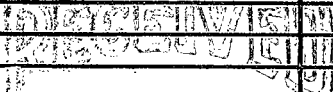

APR 20 1976

If well telescopes please sketch and show depths.

GROUND LEVEL

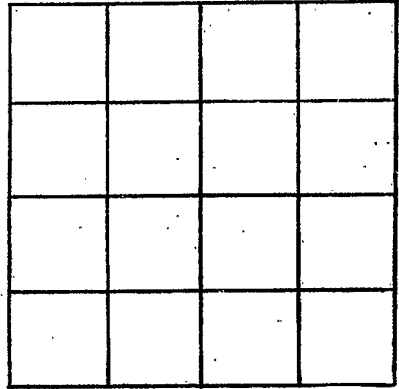

SECTION _____

Please indicate well location X.

ADDITIONAL INFORMATION

If more than one screen, show locations of each on sketch.