

Wayne
 H 2007
 4-12-76

MISSISSIPPI
 BOARD OF WATER COMMISSIONERS
 416 North State Street
 Jackson, Mississippi 39201

WATER WELL DRILLERS LOG

McILWAIN WATER WELL SERVICE WAYNE

April 12, 76
 date well completed

RT-firm name BOX 37
 WAYNESBORO MISS 39367

Wayne
 county well located

LANDOWNER:
 A. J. REYNOLDS
 WAYNESBORO, Miss
 (mailing address)


description of formations encountered	from	to
Red Clay	0	8
Red Sand	8	45
Coarse sand, some gravel	45	78
Coarse sand	78	84

WELL LOCATION:
 sec. 3/T 9 N R 7 W
 5 miles NW of W'BORO
 (distance) (direction) (nearest town)

WELL PURPOSE: HOME
 (home, irrigation, municipal, industrial)

- WELL COMPLETION DATA:
- (1) diameter (inches) 2"
 - (2) total depth (feet) 84'
 - (3) static water level (feet) 75' below top of ground.
 - (4) casing PVC 90' (material) (depth)
 2" (size) if telescope see back.
 - (5) screen 4' 80' (length) (depth to top)
 2" PVC. 008 (size) (material)
 - (6) pump 3/4 4 (HP) (yield gpm)
 110 AC (type power)
 - (7) electric log no (yes or no)

(organization running log)

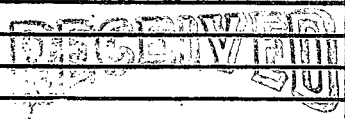

APR 20 1976

(8) how well bottom plugged

DRILLERS REMARKS:

MISS. BD. OF WATER COMMISSIONERS

