

WAYNE
 H 2010
 5-18-76

MISSISSIPPI BOARD OF WATER COMMISSIONERS
 416 North State Street
 Jackson, Mississippi 39201

WATER WELL DRILLERS LOG
 McILWAIN WATER WELL SERVICE

May 18 1976 RT. 2, BOX 37 Wayne
 date well completed WAYNESBORO, MISS. 39367 county well located

LANDOWNER:
 Billy Cran
 Waynesboro, Miss.
 (mailing address)

WELL LOCATION:
 sec. 25 T 9 N R 7 E
 3 miles N of WARD
 (distance) (direction) (nearest town)

WELL PURPOSE: Home
 (home, irrigation, municipal, industrial)

- WELL COMPLETION DATA:**
- (1) diameter (inches) 2"
 - (2) total depth (feet) 149'
 - (3) static water level (feet) 126' below top of ground.
 - (4) casing PVC ~~130'~~ 130' (material) (depth)
 2" (size) If telescope see back.
 - (5) screen NONE (length) (depth to top)
 (size) (material)
 - (6) pump 2 (HP) 6 (yield gpm)
 220 AC (type power)
 - (7) electric log NO (yes or no)
 (organization running log)
 - (8) how well bottom plugged


description of formations encountered	from	to
Red Clay	0	8
Mixed Clay	8	15
Sand	15	25
Sand & Clay	25	40
Yellow Clay	40	45
Blue Clay	45	50
Thin Rock & Clay	50	75
Blue Clay	75	120
Heavy Comb Rock	120	149

DRILLERS REMARKS:

MISS. BD. OF WATER COMMISSIONERS

If well telescopes please sketch and show depths.

GROUND LEVEL

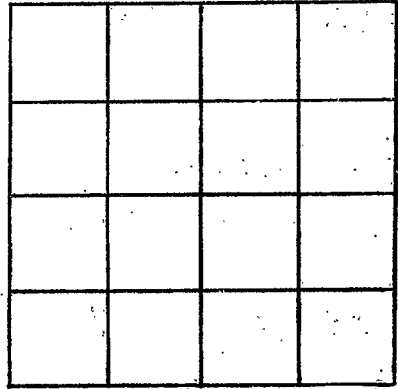

SECTION _____

Please indicate well location X.

ADDITIONAL INFORMATION

If more than one screen,
show locations of each on sketch.
