

WAYNE
H 2011
7-20-76

MISSISSIPPI
BOARD OF WATER COMMISSIONERS
416 North State Street
13P Jackson, Mississippi 39201

WATER WELL DRILLERS LOG

July 20 1976 date well completed
Porter Drilling Co. firm name
Wayne county well located

LANDOWNER: A. T. McNamee
Rt 6 Waynesboro
Miss.
(mailing address)

description of formations encountered	from	to
red clay	0	14
red sand	14	38
clay	38	58
sand	58	66
clay	66	80
clay & fine sand	80	90
or fine shelled sand	90	111
stopped on clay		

WELL LOCATION:
sec 25 T 9 N R 7 E
S W
2 miles N of Waynesboro
(distance) (direction) (nearest town)

WELL PURPOSE: home
(home, irrigation, municipal, industrial)


WELL COMPLETION DATA:
(1) diameter (inches) 2"
(2) total depth (feet) 111'
(3) static water level (feet) 93' (below above top of ground)
(4) casing P.V.C. 107'
(material) (depth)
2" if telescope see back.
(size)
(5) screen 4' 107'
(length) (depth to top)
2" 6 slot S.S.
(size) (material)
(6) pump 1 1/2 6
(HP) (yield gpm)
elec
(type power)
(7) electric log no
(yes or no)
(organization running log)
(8) how well bottom plugged
back wash valve

DRILLERS REMARKS:

RECEIVED
AUG 9 - 1976

If well telescopes please sketch and show depths.

GROUND LEVEL

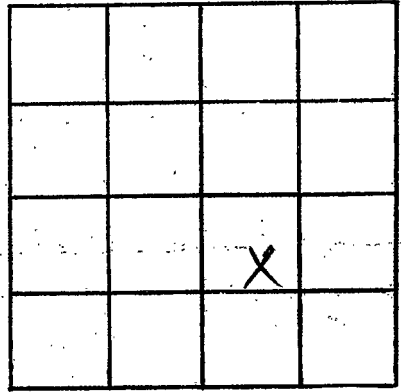

SECTION 25

Please indicate well location X.

ADDITIONAL INFORMATION

If more than one screen, show locations of each on sketch.