

Wayne
 H 512
 10/12/76

MISSISSIPPI
 BOARD OF WATER COMMISSIONERS
 416 North State Street
 Jackson, Mississippi 39201

13P

WATER WELL DRILLERS LOG

Oct 12 1976 *Poster Drilling Co* *Wayne*
 date well completed firm name county well located

LANDOWNER: <i>Larry Stanley</i>	description of formations encountered	from	to
<i>Arden Dr</i>			
<i>2445 S. Magnolia Miss.</i> (mailing address)	<i>Clay & sand</i>	<i>0</i>	<i>16</i>
	<i>sub. clay</i>	<i>16</i>	<i>24</i>
	<i>rock</i>	<i>24</i>	<i>27</i>
	<i>clay</i>	<i>27</i>	<i>154</i>
	<i>substrata</i>	<i>154</i>	<i>172</i>
	<i>clay</i>	<i>172</i>	<i>240</i>
	<i>rock strata</i>	<i>240</i>	<i>258</i>
	<i>fine sand & clay</i>		
	<i>coar sand</i>	<i>258</i>	<i>270</i>

WELL LOCATION:
 sec. 11 T. 9 N. R. 7 E. S. 5 W.
 (distance) miles (direction) of (nearest town)
5 miles N of Magnolia

WELL PURPOSE: *home*
 (home, irrigation, municipal, industrial)

- WELL COMPLETION DATA:
- (1) diameter (inches) 2"
 - (2) total depth (feet) 270
 - (3) static water level (feet) 54 below top of ground.
 - (4) casing steel 258'
(material) (depth)
2' If telescope see back.
(size)
 - (5) screen 11 259'
(length) (depth to top)
1 1/4 6 slot S.S.
(size) (material)
 - (6) pump 2 8
(HP) (yield gpm)
elec.
(type power)
 - (7) electric log no
(yes or no)
- (organization running log)

(8) how well bottom plugged
flush joint

DRILLERS REMARKS:

description of formations encountered		from	to
<i>Clay & sand</i>		<i>0</i>	<i>16</i>
<i>sub. clay</i>		<i>16</i>	<i>24</i>
<i>rock</i>		<i>24</i>	<i>27</i>
<i>clay</i>		<i>27</i>	<i>154</i>
<i>substrata</i>		<i>154</i>	<i>172</i>
<i>clay</i>		<i>172</i>	<i>240</i>
<i>rock strata</i>		<i>240</i>	<i>258</i>
<i>fine sand & clay</i>			
<i>coar sand</i>		<i>258</i>	<i>270</i>
<i>slight on clay</i>			
<i>11' 6 slot 1 1/4 S.S.</i>			
<i>screen with 5' 1 1/4</i>			
<i>top pipe heat in</i>			
<i>with rubber packs</i>			
<i>126' 1 1/4" steel</i>			
<i>large pipe</i>			


RECEIVED
 NOV - 8 1976

MISS. BD. OF WATER COMMISSIONERS

nd

If well telescopes please sketch and show depths.

GROUND LEVEL

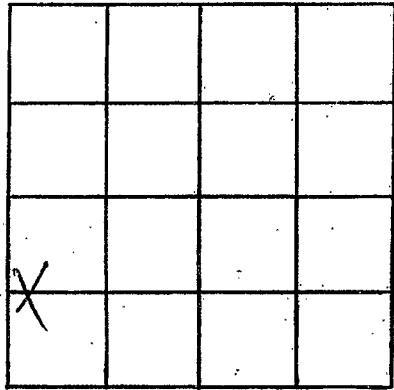

SECTION 11

Please indicate well location X.

ADDITIONAL INFORMATION

Lined area for additional information.

If more than one screen, show locations of each on sketch.