

WAYNE  
H 2013  
10/29/76

MISSISSIPPI  
BOARD OF WATER COMMISSIONERS  
416 North State Street  
Jackson, Mississippi 39201

WATER WELL DRILLERS LOG

Oct 29 1976 Rock Drilling & Pipe Wayne  
date well completed firm name county well located

LANDOWNER: Joel Williams description of formations encountered from to  
241 Waynesboro sand & clay 0 54  
 (mailing address) stone on clay  
 some sand

WELL LOCATION:  
 sec. 33 T 9 N R 7 E  
3 miles NW of Waynesboro  
 (distance) (direction) (nearest town)

WELL PURPOSE: Home  
 (home, irrigation, municipal, industrial)

WELL COMPLETION DATA:  
 (1) diameter (inches) 2"  
 (2) total depth (feet) 52'  
 (3) static water level (feet) 38' below above top of ground.  
 (4) casing PVC 47'  
 (material) (depth)  
2" If telescope see back.  
 (size)  
 (5) screen 5' 147'  
 (length) (depth to top)  
1 1/2" slot SS  
 (size) (material)  
 (6) pump 1 6  
 (HP) (yield gpm)  
elec.  
 (type power)  
 (7) electric log no  
 (yes or no)  
 (organization running log)

(8) how well bottom plugged  
1 1/2" back wash valve

DRILLERS REMARKS:


description of formations encountered	from	to
sand & clay stone on clay some sand	0	54
1 1/2" slot SS		
screwed on end of Casing with 1 1/2" back wash valve on end		
45' 1" PVC drop pipe		

RECEIVED  
 NOV - 3 1976

MISS. Bd. OF WATER COMMISSIONERS

If well telescopes please sketch and show depths.

GROUND LEVEL

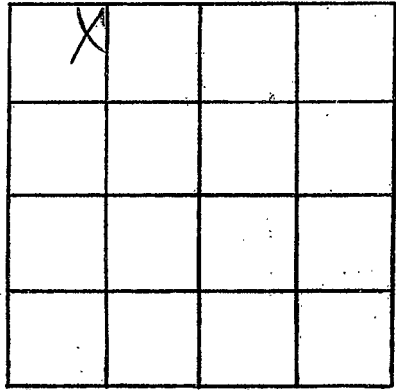

SECTION 33

Please indicate well location X.

ADDITIONAL INFORMATION

If more than one screen,  
show locations of each on sketch.