

Wayne
H 2015
2-23-77

MISSISSIPPI
BOARD OF WATER COMMISSIONERS
416 North State Street
Jackson, Mississippi 39201

WATER WELL DRILLERS LOG

McILWAIN WATER WELL SERVICE Wayne

Feb 23 1977 date well completed
Waynesboro Miss. 39267 RT-firm name BOX 31 county well located


LANDOWNER:	description of formations encountered	from	to
Mr. Chester Dean			
Waynesboro Miss. (mailing address)	Red Sand	10	22
WELL LOCATION:	Coarse Sand + Pea Gravel	22	50
sec. 7 T. 9 N R. 7 8 miles NW of W'boro (distance) (direction) (nearest town)	land	50	61
WELL PURPOSE: Home (home, irrigation, municipal, industrial)			
WELL COMPLETION DATA:			
(1) diameter (inches) 2"			
(2) total depth (feet) 61'			
(3) static water level (feet) 50' below top of ground.			
(4) casing PVC, 56' (material) (depth) 2" If telescope see back. (size)			
(5) screen 5', 56' (length) (depth to top) 2", PVC .008 (size) (material)			
(6) pump 1/2 HP, 4 (yield gpm) 110 AC (type power)			
(7) electric log No (yes or no)			
(organization running log)			
(8) how well bottom plugged			
DRILLERS REMARKS:			

RECEIVED
MAR 2 1 1977

MISS. BD. OF WATER COMMISSIONERS

If well telescopes please sketch and show depths.

GROUND LEVEL

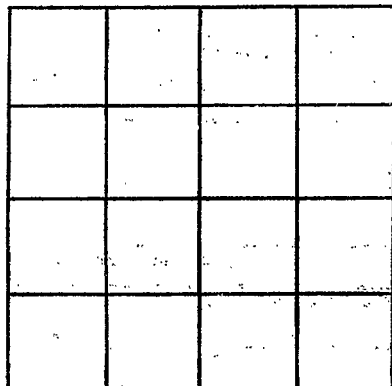

SECTION _____

Please indicate well location X.

ADDITIONAL INFORMATION

If more than one screen,
show locations of each on sketch.