

WAYNE  
H 2016  
3-3-77

MISSISSIPPI  
BOARD OF WATER COMMISSIONERS  
416 North State Street  
Jackson, Mississippi 39201

WATER WELL DRILLERS LOG

March 3  
date well completed

13P WATNESEBORO, MISS. 39367  
firm name  
RT. 2, BOX 37

Wayne  
county well located


LANDOWNER:	description of formations encountered	from	to
Mrs. L. K. Jeard	Red Clay	0	12
Waynesboro Miss. (mailing address)	Red Sand	12	20
WELL LOCATION:	Clay	20	35
sec. 25 T 9 N R 7 E 3 miles N of Wboro (distance) (direction) (nearest town)	Blue clay	35	40
WELL PURPOSE: Home (home, irrigation, municipal, industrial)	lime Rocks + Clay	40	63
WELL COMPLETION DATA:	Blue Clay	63	100
(1) diameter (inches) 2"	Med. sand	100	110
(2) total depth (feet) 110'			
(3) static water level (feet) 85' below top of ground.			
(4) casing PVC, 105' (material) (depth) 2" If telescope see back. (size)			
(5) screen 5', 105' (length) (depth to top) 2", PVC .008 (size) (material)			
(6) pump 1 6 (HP) (yield gpm) 220 AC (type power)			
(7) electric log No (yes or no)			
(organization running log)			
(8) how well bottom plugged			
DRILLERS REMARKS:			

RECEIVED  
MAR 14 1977

MISS. BD. OF WATER COMMISSIONERS

If well telescopes please sketch and show depths.

GROUND LEVEL

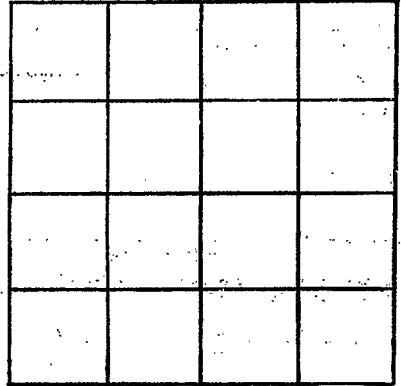

SECTION \_\_\_\_\_

Please indicate well location X.

ADDITIONAL INFORMATION

If more than one screen, show locations of each on sketch.