

Wayne
H 2017
3/8/77

MISSISSIPPI
BOARD OF WATER COMMISSIONERS
416 North State Street
Jackson, Mississippi 39201

WATER WELL DRILLERS LOG

MILWAUIN WATER WELL SERVICE

March 8 1977
date well completed

RT. firm name
WAYNESBORO MISS. 39367


Wayne
county well located

LANDOWNER:	description of formations encountered	from	to
Mr. George Waller Waynesboro Miss (mailing address)			
WELL LOCATION:	Clay	20	33
sec. 19 T-9 N R-7 E le miles NW of W'boro (distance) (direction) (nearest town)	Sand	33	50
WELL PURPOSE: Home (home, irrigation, municipal, industrial)	Sand + Clay	50	62
WELL COMPLETION DATA:	Clay	62	67
(1) diameter (inches) 2"	Coarse Sand	67	80
(2) total depth (feet) 102'	Sand + Clay	80	90
(3) static water level (feet) 92 1/2' below top of ground	Coarse Sand	90	102
(4) casing PVC 97' (material) (depth) 2" (size) if telescope see back.			
(5) screen 5' 97' (length) (depth to top) 2" PVC :008 (size) (material)			
(6) pump 1 5 (HP) (yield gpm) 110 AC (type power)			
(7) electric log No (yes or no)			
(organization running log)			
(8) how well bottom plugged			
DRILLERS REMARKS:			

RECEIVED
MAR 14 1977
MISS. BD. OF WATER COMM.

If well telescopes please sketch and show depths.

GROUND LEVEL

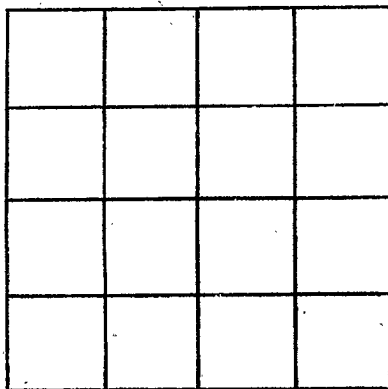

SECTION _____

Please indicate well location X.

ADDITIONAL INFORMATION

If more than one screen, show locations of each on sketch.