

WAYNE
H 20A
3-17-77

MISSISSIPPI
BOARD OF WATER COMMISSIONERS
416 North State Street
Jackson, Mississippi 39201

WATER WELL DRILLERS LOG

March 17, 19**77** **McILWAIN WATER WELL SERVICE Wayne** **MISS**
date well completed RT. file no. **EX 37** county well located

LANDOWNER:
Charles Holifield
Wagnersboro Miss.
(mailing address)

WELL LOCATION:
sec. **33** **T 9** N R **7** W
3 miles **NW** of **W'boro**
(distance) (direction) (nearest town)

WELL PURPOSE: Home
(home, irrigation, municipal, industrial)

WELL COMPLETION DATA:

(1) diameter (inches) 2"
(2) total depth (feet) 36'
(3) static water level (feet) 24' below top of ground.
(4) casing PVC 31'
(material) (depth)
2" if telescope see back.
(size)
(5) screen 5' 31'
(length) (depth to top)
2", PVC .008
(size) (material)
(6) pump 1/2 6
(HP) (yield gpm)
110 AC
(type power)
(7) electric log No
(yes or no)
(organization running log)
(8) how well bottom plugged


description of formations encountered	from	to
Red Clay	0	8
Red Sand	8	16
Sand + Clay	16	25
Sand	25	36

RECEIVED
MAY 21 1977
MISS. BD. OF WATER COMMISSIONERS

DRILLERS REMARKS:

If well telescopes please sketch and show depths.

GROUND LEVEL

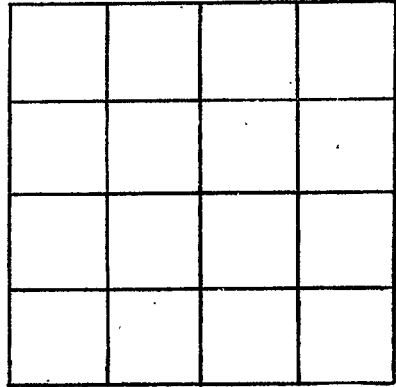

SECTION _____

Please indicate well location X.

ADDITIONAL INFORMATION

If more than one screen, show locations of each on sketch.