

WAYNE
H 0000
5-5-77

MISSISSIPPI
BOARD OF WATER COMMISSIONERS
416 North State Street
Jackson, Mississippi 39201

WATER WELL DRILLERS LOG

May 5 1977
date well completed

130 RAILWAY WATER WELL SERVICE Wayne MS
RI. firm name X 37 county well located

LANDOWNER:
Buddy Lee
Waynesboro Miss
(mailing address)

description of formations encountered	from	to
Sand	0	14
Clay	14	15
Gumbo Rock	15	28
Blue Clay + Gumbo Rock	28	50
Clay	50	60
Rock - shells + sandy Marl	60	80
Brown Clay	80	81
Sand	81	88

WELL LOCATION:
sec. 35 T 9 N R 7 W
2 miles NW of Wboro
(distance) (direction) (nearest town)

WELL PURPOSE: Name
(home, irrigation, municipal, industrial)

- WELL COMPLETION DATA:
- (1) diameter (inches) 2"
 - (2) total depth (feet) 88'
 - (3) static water level (feet) 24' below above top of ground.
 - (4) casing PVC 83' (material) (depth)
2" (size) If telescope see back.
 - (5) screen 5' 83' (length) (depth to top)
2" PVC .008 (size) (material)
 - (6) pump 1/2 6 (HP) (yield gpm)
110 AC (type power)
 - (7) electric log No (yes or no)
(organization running log)
 - (8) how well bottom plugged


RECEIVED
MAY 31 1977

MISS. BD. OF WATER COMMISSIONERS

DRILLERS REMARKS:

If well telescopes please sketch and show depths.

GROUND LEVEL

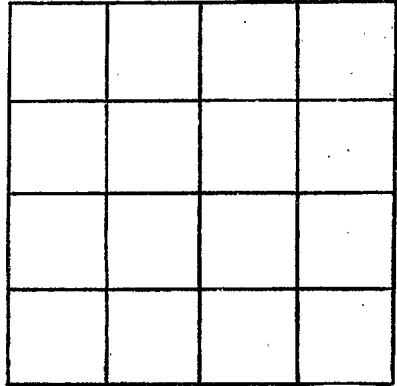

SECTION _____

Please indicate well location X.

ADDITIONAL INFORMATION

If more than one screen, show locations of each on sketch.