

WAYNE
H 2023
7-13-77

MISSISSIPPI
BOARD OF WATER COMMISSIONERS
416 North State Street
13P Jackson, Mississippi 39201

WATER WELL DRILLERS LOG

July 13 1977 date well completed
Porter Drilling firm name
Wayne county well located

LANDOWNER: Fred Schi
Clements
At 122 Wagnersboro Miss (mailing address)

description of formations encountered	from	to
	sand	0
loose sand	8	30
firm sand	30	56

WELL LOCATION:
sec. 8 T. 90 N R. 7 E
5 miles NW Wagnersboro (distance) (direction) of (nearest town)

4 2' 1" P.V. 2 drop
Pipes

WELL PURPOSE: none
(home, irrigation, municipal, industrial)

- WELL COMPLETION DATA:
- (1) diameter (inches) 2"
 - (2) total depth (feet) 56'
 - (3) static water level (feet) 34' below top of ground.
 - (4) casing P.V.C. 52' (material) (depth)
2" (size) if telescope see back.
 - (5) screen 4' 52' (length) (depth to top)
2" (size) 6 scht 5.5 (material)
 - (6) pump 1 (HP) 12 (yield gpm)
elec. (type power)
 - (7) electric log (yes or no)
 - (organization running log)
 - (8) how well bottom plugged 1/4 back
wash water


DRILLERS REMARKS:
No circulation at 8'
set 4" case pullout
when well finished

RECEIVED
JUL 29 1977

MISS. BB. OF WATER COMMISSIONERS

If well telescopes please sketch and show depths.

GROUND LEVEL

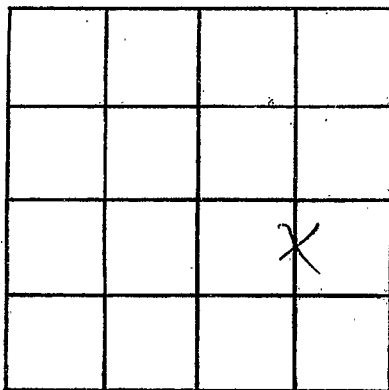

SECTION 2

Please indicate well location X.

ADDITIONAL INFORMATION

If more than one screen,
show locations of each on sketch.