

WAYNE
H 2004
7-14-77

MISSISSIPPI
BOARD OF WATER COMMISSIONERS
416 North State Street
13P Jackson, Mississippi 39201

WATER WELL DRILLERS LOG
MILWAIN WATER WELL SERVICE

Box 37
Waynesboro, Miss. 39368

Wayne
county well located

July 14
date well completed 19 77


LANDOWNER:	description of formations encountered	from	to
Mr. Freddie Whitfield Waynesboro Miss. (mailing address)			
WELL LOCATION:	Red Sand	5	14
sec. 12 T. 9 N R. 7 W 6 1/2 miles N of W'boro (distance) (direction) (nearest town)	Clay	14	17
WELL PURPOSE: Home (home, irrigation, municipal, industrial)	Sand	17	31
WELL COMPLETION DATA:			
(1) diameter (inches) 2"			
(2) total depth (feet) 31'			
(3) static water level (feet) 18' below top of ground.			
(4) casing PVC 26' (material) (depth) 2" If telescope see back. (size)			
(5) screen 5' 26' (length) (depth to top) 2" PVC 008 (size) (material)			
(6) pump 1/2 6 (HP) (yield gpm) 110 AC (type power)			
(7) electric log No (yes or no) (organization running log)			
(8) how well bottom plugged			
DRILLERS REMARKS:			

RECEIVED
SEP 19 1977

MISS. BD. OF WATER

If well telescopes please sketch and show depths.

GROUND LEVEL

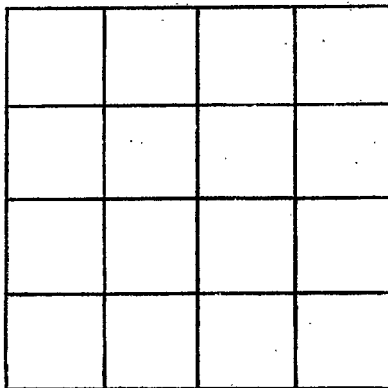

SECTION _____

Please indicate well location X.

ADDITIONAL INFORMATION

If more than one screen, show locations of each on sketch.