

WAYNE
H 2025
7-18-77

MISSISSIPPI
BOARD OF WATER COMMISSIONERS
416 North State Street
13^p Jackson, Mississippi 39201

WATER WELL DRILLERS LOG

July 18

19 MAILWAIN WATER WELL SERVICE

Wayne

date well completed

RT. 2nd nth 3rd W

county well located

WAYNESBORO, MISS. 39367

LANDOWNER:	description of formations encountered	from	to
Mr. J. H. Canady Waynesboro, Miss. (mailing address)			
WELL LOCATION:	Sand + Gravel	3	25
sec. 19 T. 9 N. R. 7 W. 5 miles NW of Waynesboro (distance) (direction) (nearest town)	Blue Clay	25	52
WELL PURPOSE: Home (home, irrigation, municipal, industrial)	Lime Rock + Clay	52	70
WELL COMPLETION DATA:	Clay	70	93
(1) diameter (inches) 2"	Rock + Clay	93	100
(2) total depth (feet) 100'			
(3) static water level (feet) 15' below top of ground.			
(4) casing PVC 74' (material) (depth) 2" if telescope see back. (size)			
(5) screen (length) (depth to top) (size) (material)			
(6) pump 1 12 (HP) (yield gpm) 220 AC (type power)			
(7) electric log No (yes or no)			
(organization running log)			
(8) how well bottom plugged			
DRILLERS REMARKS:			


RECEIVED

SEP 19 1977

MISS. BD. OF WATER COMMISSIONERS

If well telescopes please sketch and show depths.

GROUND LEVEL

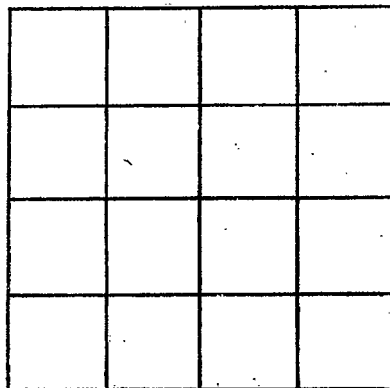

SECTION _____

Please indicate well location X.

ADDITIONAL INFORMATION

If more than one screen, show locations of each on sketch.