

WAYNE  
H [Signature]  
7-22-77

MISSISSIPPI  
BOARD OF WATER COMMISSIONERS  
416 North State Street  
Jackson, Mississippi 39201

13P

WATER WELL DRILLERS LOG

July 22  
date well completed

1977 ~~WAIN~~ WATER WELL SERVICE WAYNE

RT. 2, BOX 37

county well located

WAYNESBORO, MISS. 39367

LANDOWNER:	description of formations encountered	from	to
Melvin Evans			
Waynesboro Miss. (mailing address)	Clay	5	8
WELL LOCATION:	Clay + Rock	8	16
sec. 27 T 9 N R 7 W	Rock	16	18
3 miles NW of W'boro	Rock + Cavities	18	25
(distance) (direction) (nearest town)	Rock + Clay	25	50
WELL PURPOSE: Home	Clay	50	61
(home, irrigation, municipal, industrial)	Sand	61	85
WELL COMPLETION DATA:			
(1) diameter (inches) 4" x 2"			
(2) total depth (feet) 85'			
(3) static water level (feet) 15' below above top of ground.			
(4) casing PVC 4" - 29' (material) (depth)			
(size) If telescope see back.			
(5) screen 10' 75' (length) (depth to top)			
2" PVC .008 (size) (material)			
(6) pump 3/4 10 (HP) (yield gpm)			
220 AC (type power)			
(7) electric log NO (yes or no)			
(organization running log)			
(8) how well bottom plugged			


RECEIVED  
SEP 19 1977

DRILLERS REMARKS:

MISS. BD. OF WATER COMM

If well telescopes please  
sketch and show depths.

GROUND LEVEL

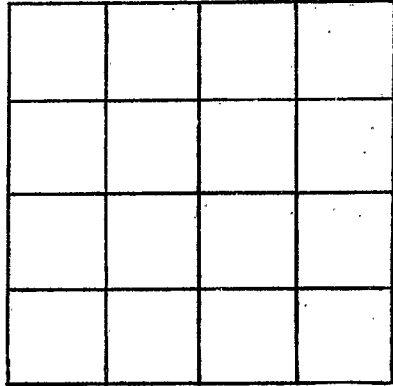

SECTION \_\_\_\_\_

Please indicate well location X.

ADDITIONAL INFORMATION

If more than one screen,  
show locations of each on sketch.